
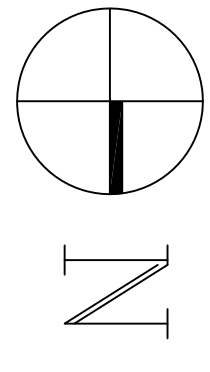


GENERAL NOTES

1. THIS AS BUILT ROOMING REPRESENTS THE REEVES MUNICIPAL CENTER AS OF 04/08/02
2. INTERIOR FLOOR AREA MEASURED FROM WALL TO WALL OF

KEY

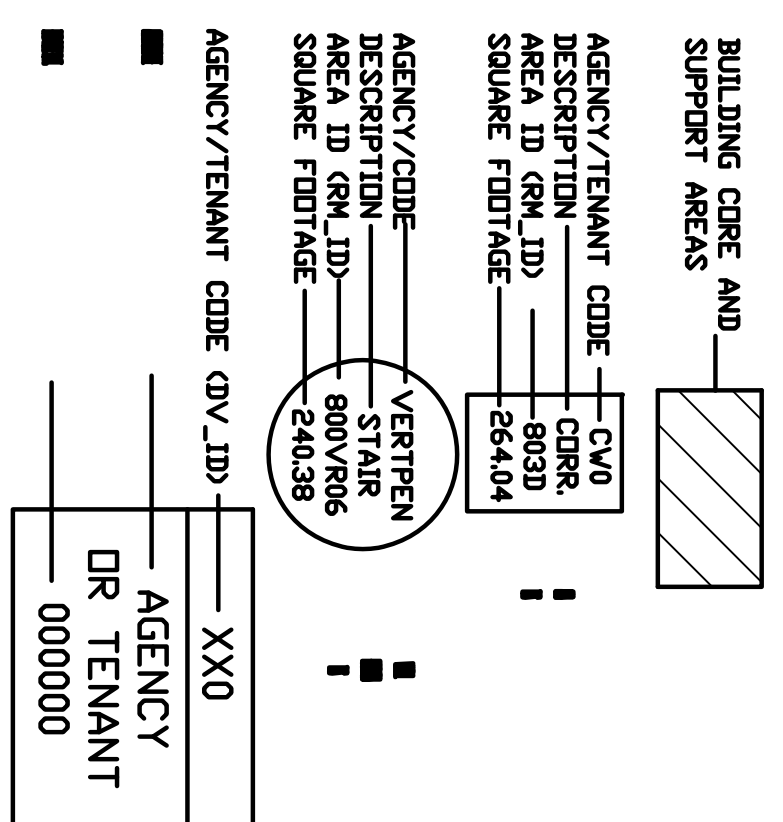

DESIGNED	DATE	DESCRIPTION	BY	APP
CHECKED	DATE	DESCRIPTION		
CERTIFICATION				
PROJECT DRAWINGS				
6TH FLOOR PLAN AS BUILT				
Reeves Municipal Center 2000 14th Street, NW Washington, District of Columbia				
FINAL SUBMISSION				
PROJECT NO.	DATE	DESCRIPTION	BY	APP
11.6a	01/21/2002			
SCALE: 1/8" = 1'-0"				