
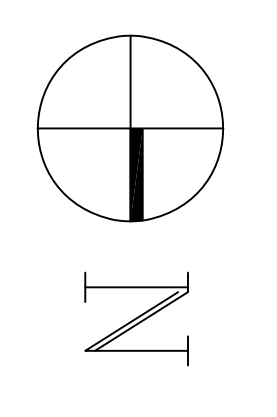


GENERAL NOTES

1. THIS AS BUILT DRAWING REPRESENTS AS OF 04/08/02
2. INTERIOR FLOOR AREA MEASURED FROM WALL = 45453 SF

KEY

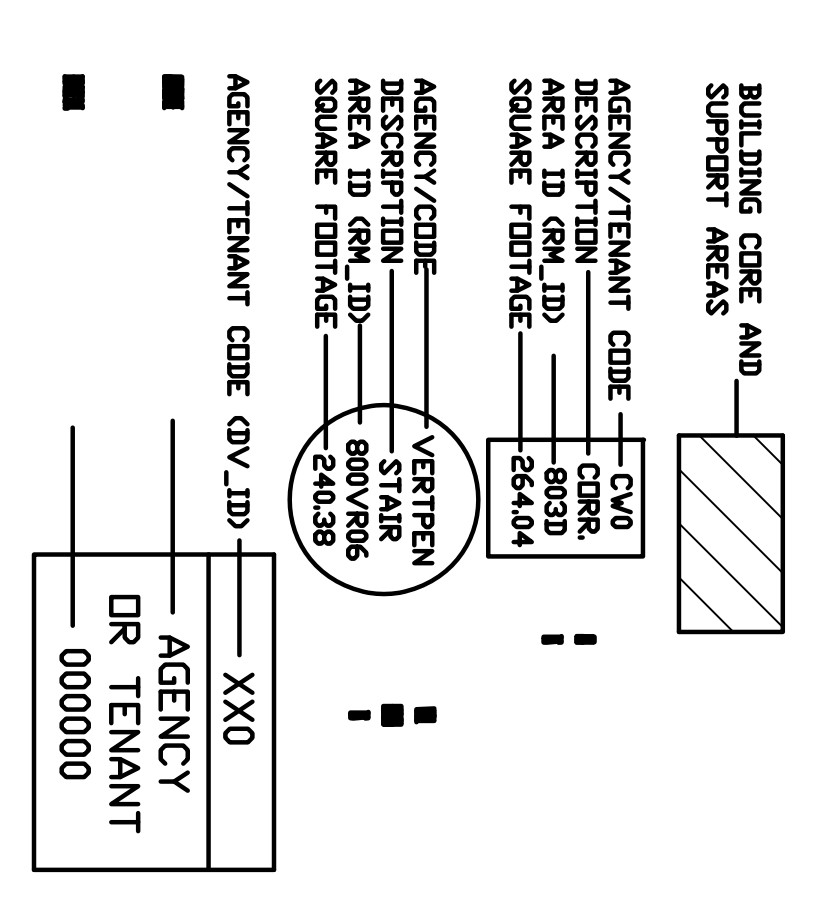

DESIGNED	DATE	DESCRIPTION	BY	APP
CHECKED	DATE	TENANT DIAGRAMS		
CERTIFICATION	DATE	CHANGE		
DRAWING NO. 6TH FLOOR TENANT DIAGRAM				
Reeves Municipal Center 2000 14th Street, NW Washington, District of Columbia				
FINAL SUBMISSION				
PROJECT NO.	DATE	SCALE		
602.000.0002	04/21/2002	SCALE: 1/8" = 1'-0"		

X1.6b