

LOBBY MECH ROOM
117

AS-BUILT DIM
7'-3"

B4
A-448

A5
A-501

B5
A-302

C3
A-507

103A
1A/25

104A
1A/1B

D2

19'-11 3/4"

37'-9 3/8"

ASK-73
1/13

9'-1/8"

32'-0"

F
E

119A
1A/3B

32'-0"

20'-9 3/8"

5'-0"

17'-3"

29'-3 3/8"

A3
A-473

SOUTH ART LOBBY
100

29'-3 3/8"

D
C

EXISTING STAIR 3
C1

31'-2"

A1
A-507

118B
4F/09

118A
7F/08

118D
4F/17

118C
7F/10

9'-1/2"

6'-0"

1'-0 1/2"

VESTIBULE
118

29'-3 3/8"

A5
A-110P

A3
A-110P

123
2A/07

28'-0"

103C
2A/08

28'-0"

29'-5 1/4"

A

26'-2"

24'-10 1/2"

214'-4"

24'-3"

24'-2 1/2"

24'-2 1/2"

19'-7 3/4"

21'-0 1/4"

9'-1 1/2"

3'-11 1/2"

3'-0"

2'-3"

C5
A--01

C5
A-210

QR
D

E

QR

F

QR

G

H


QR

J


K

PA


200 EYE STREET MAIN LOBBY
ART GALLERY LAYOUT

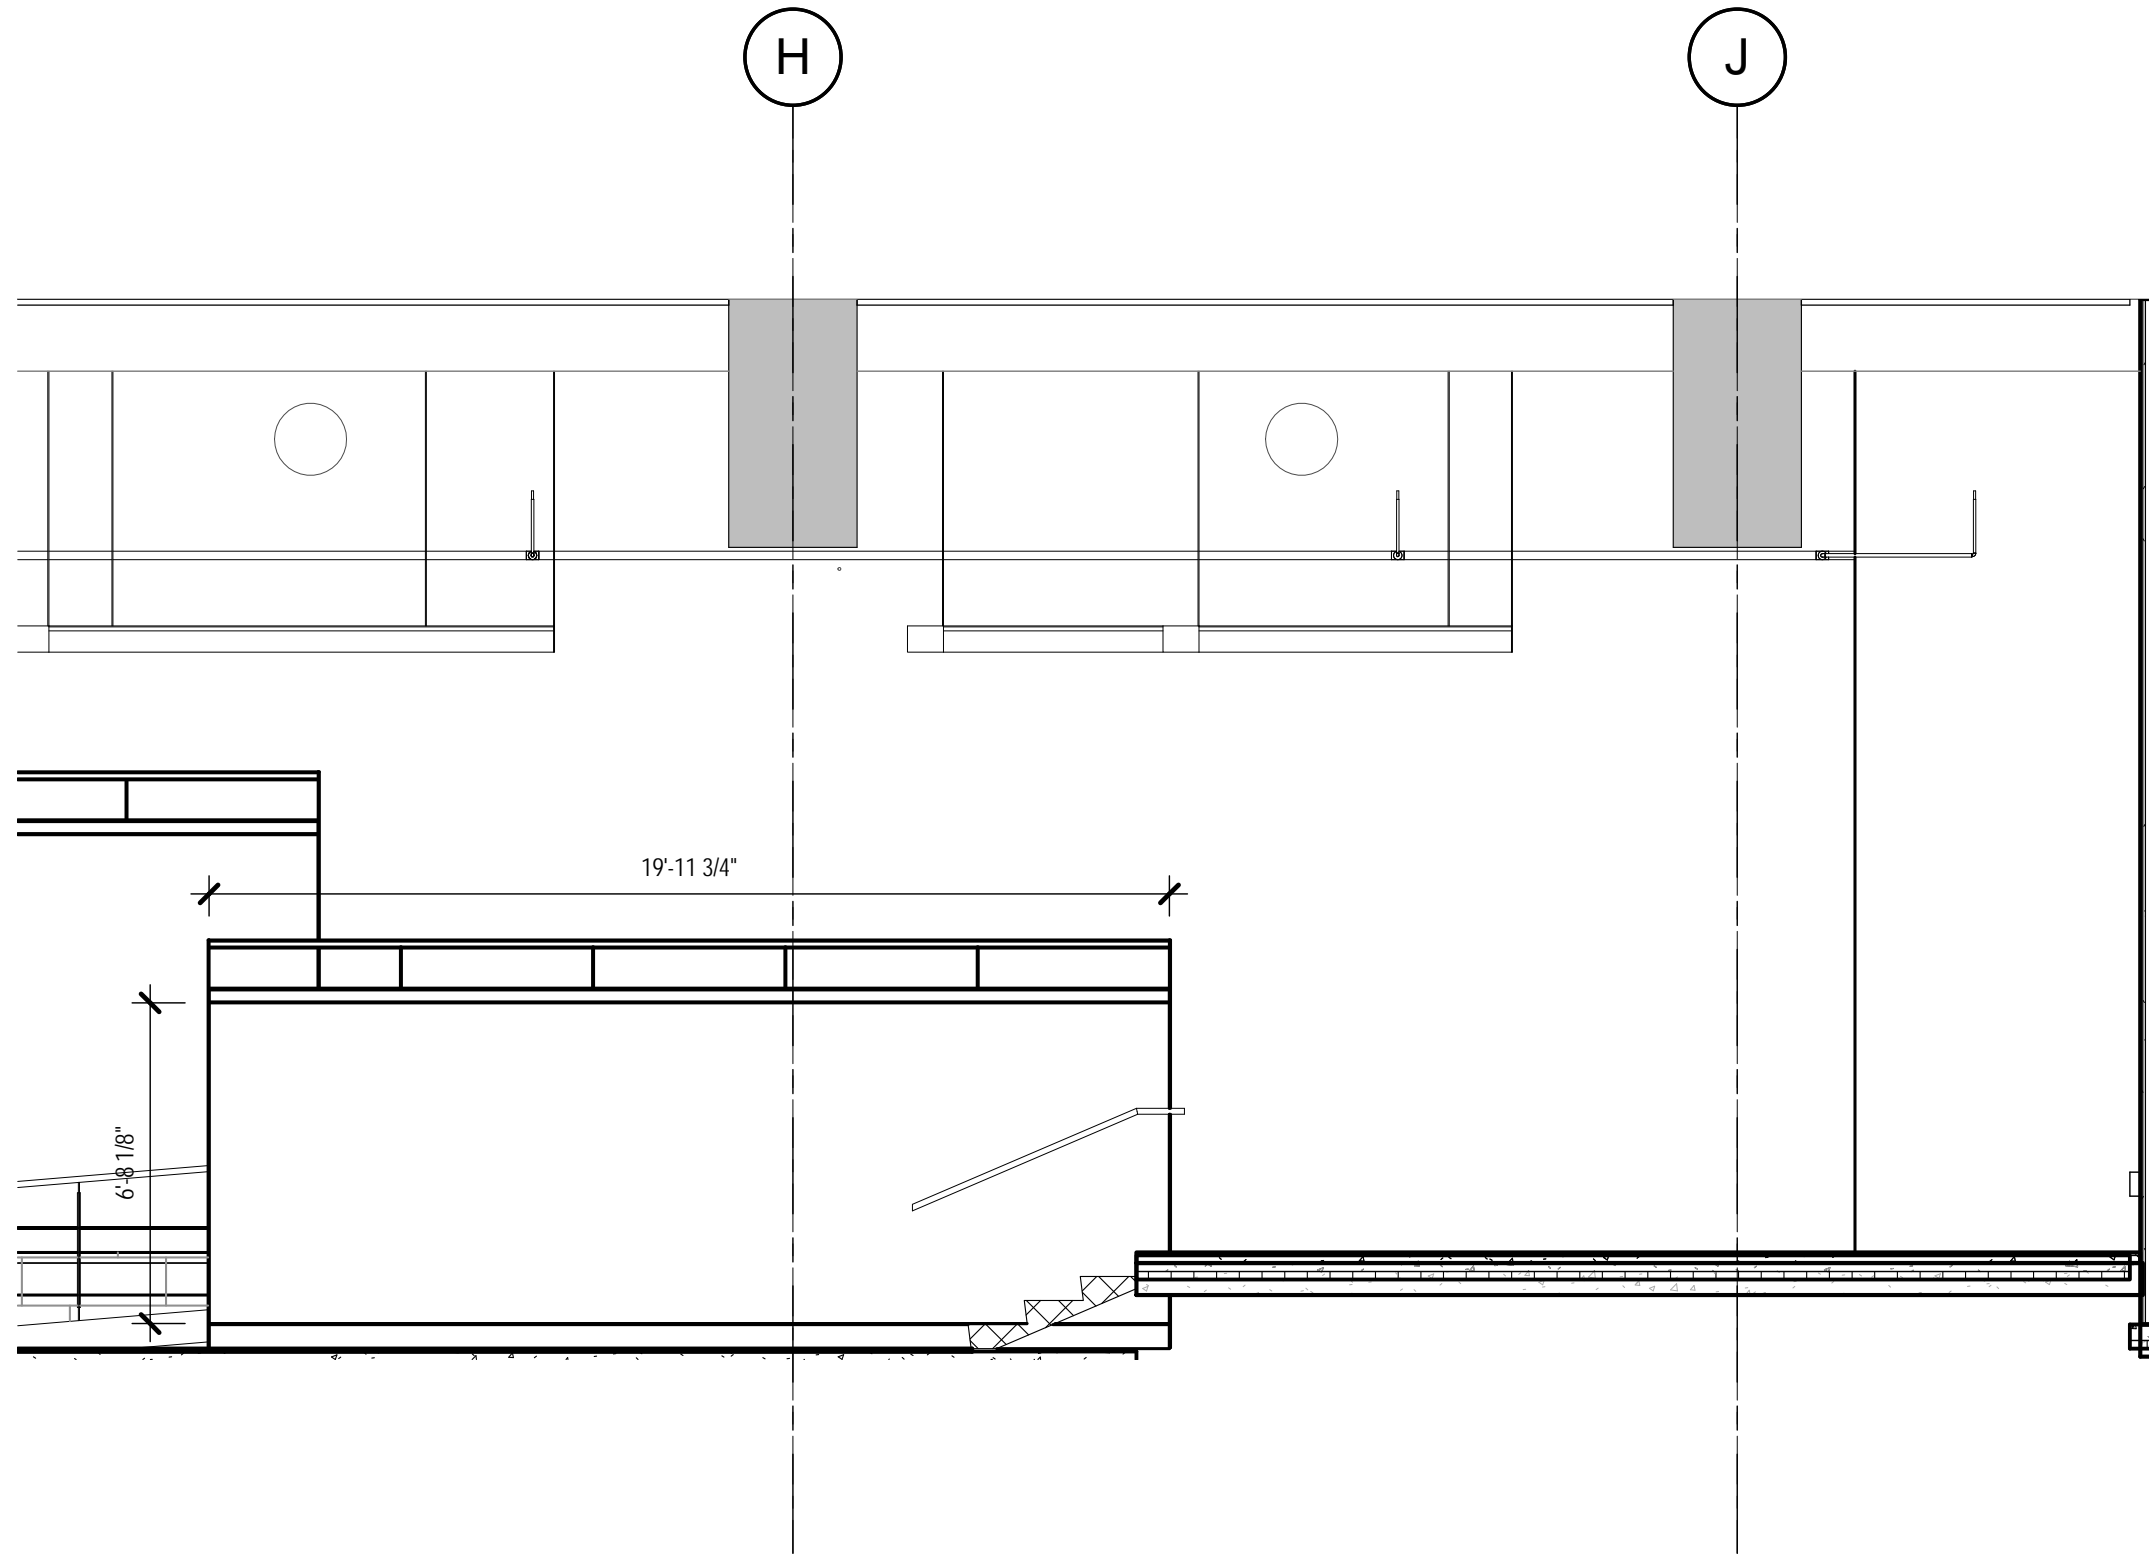


ELEVATION "A"

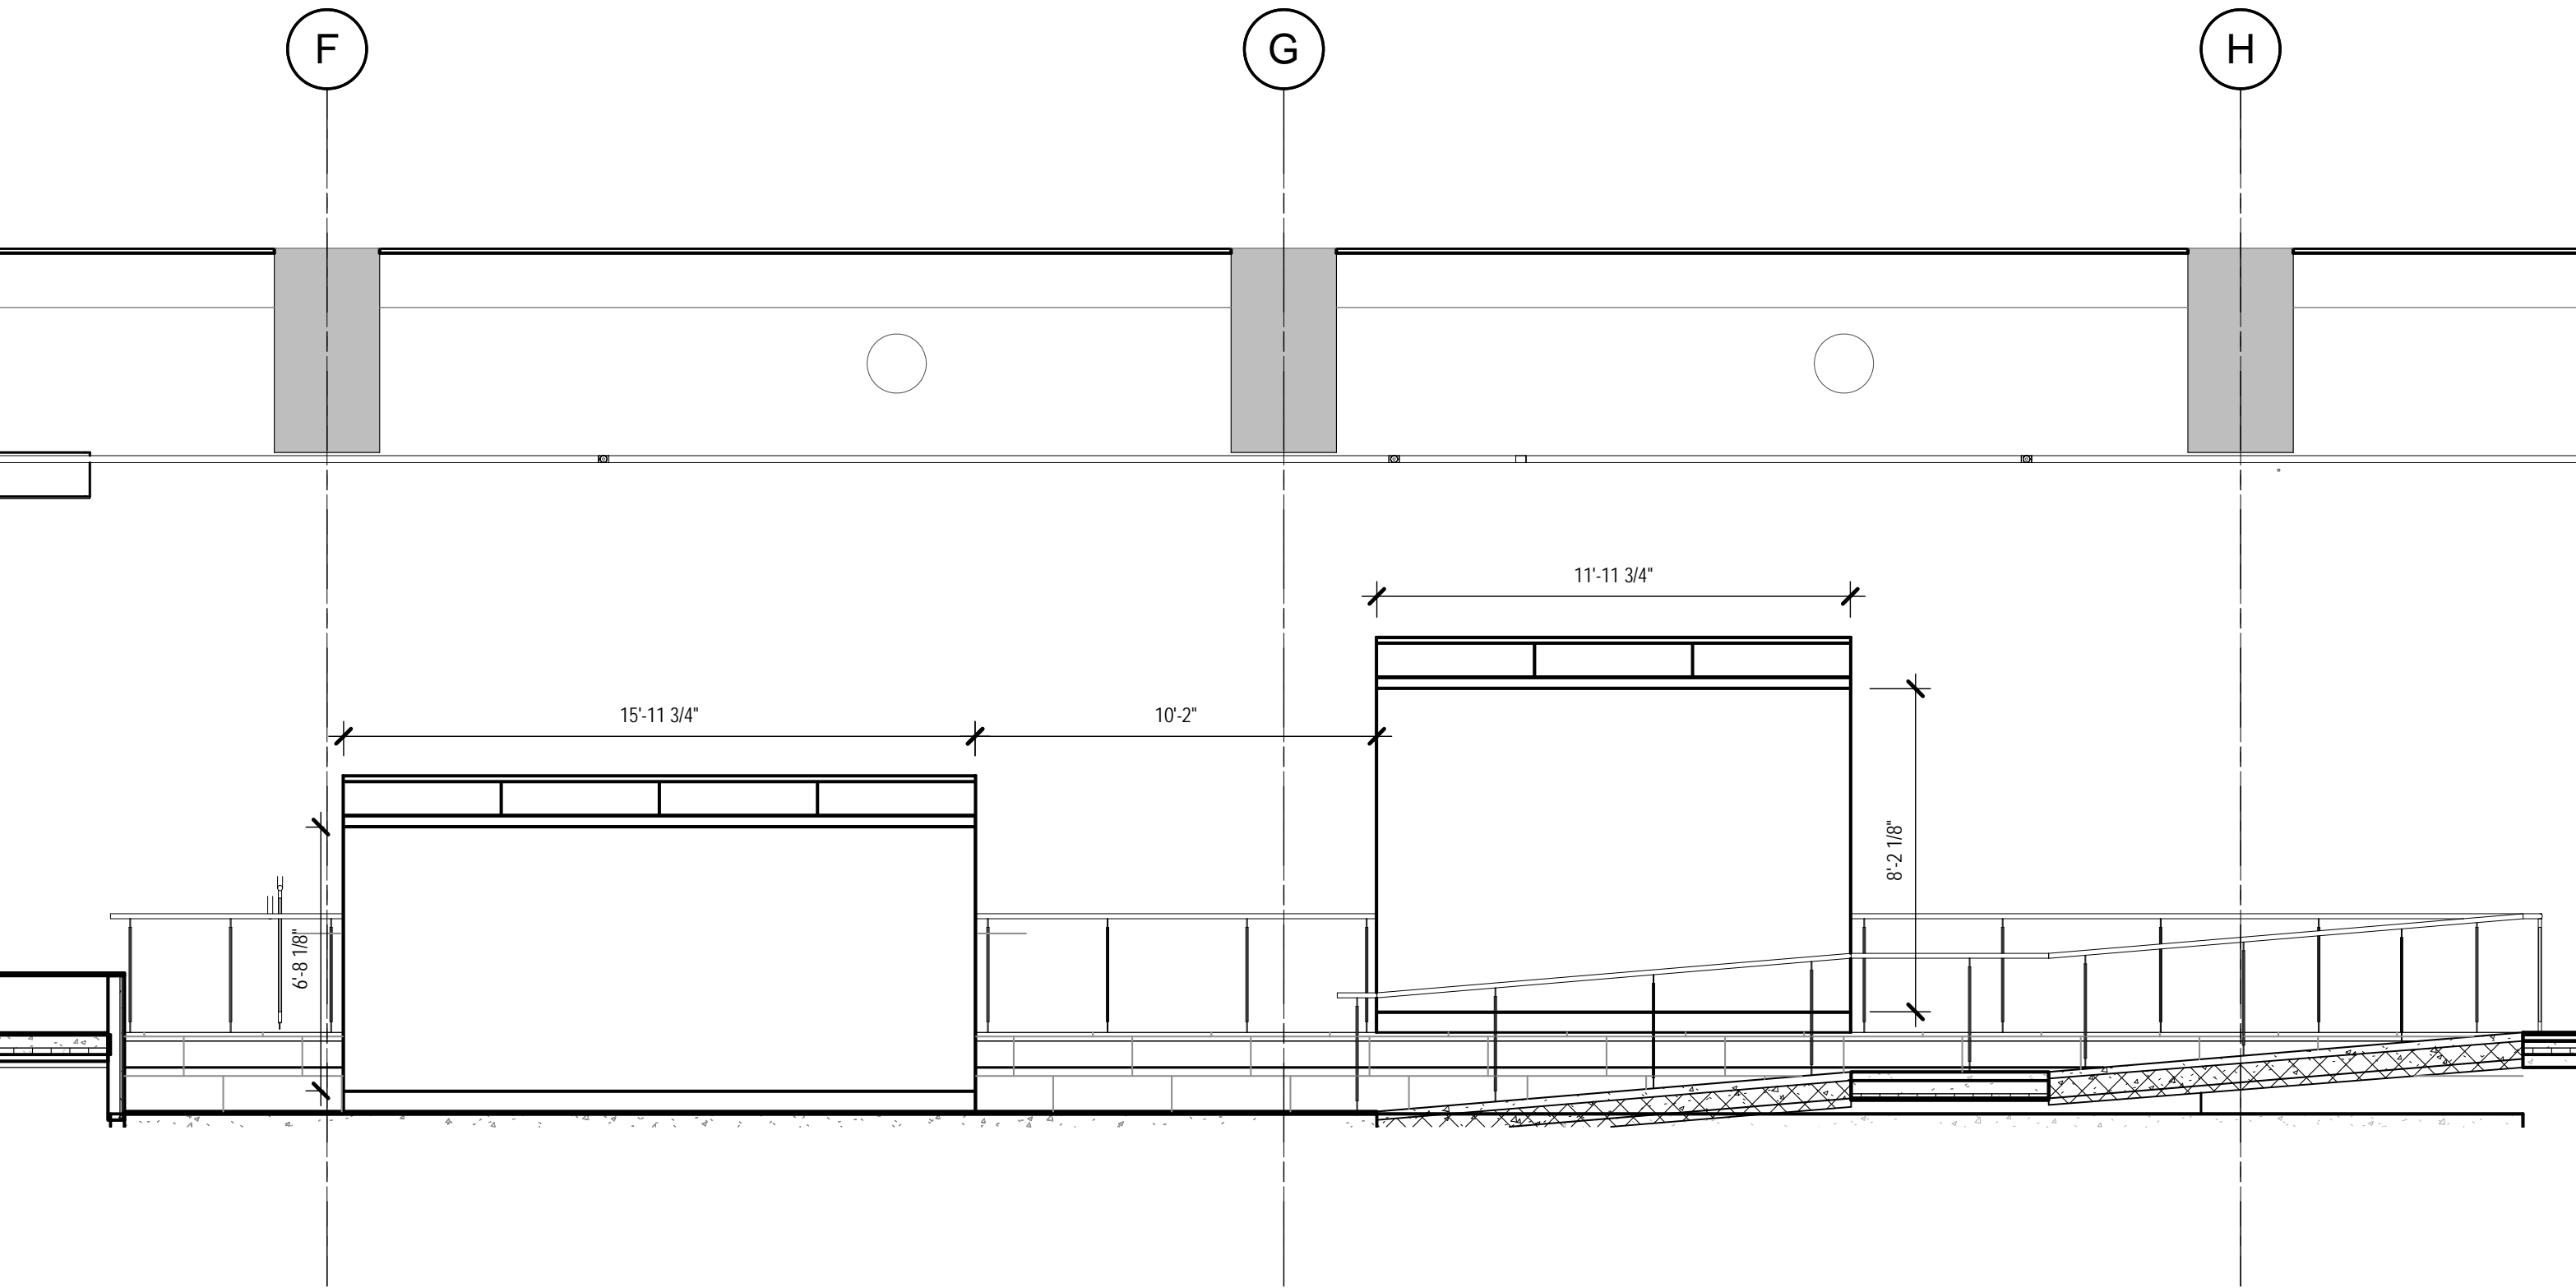


ELEVATION "B"

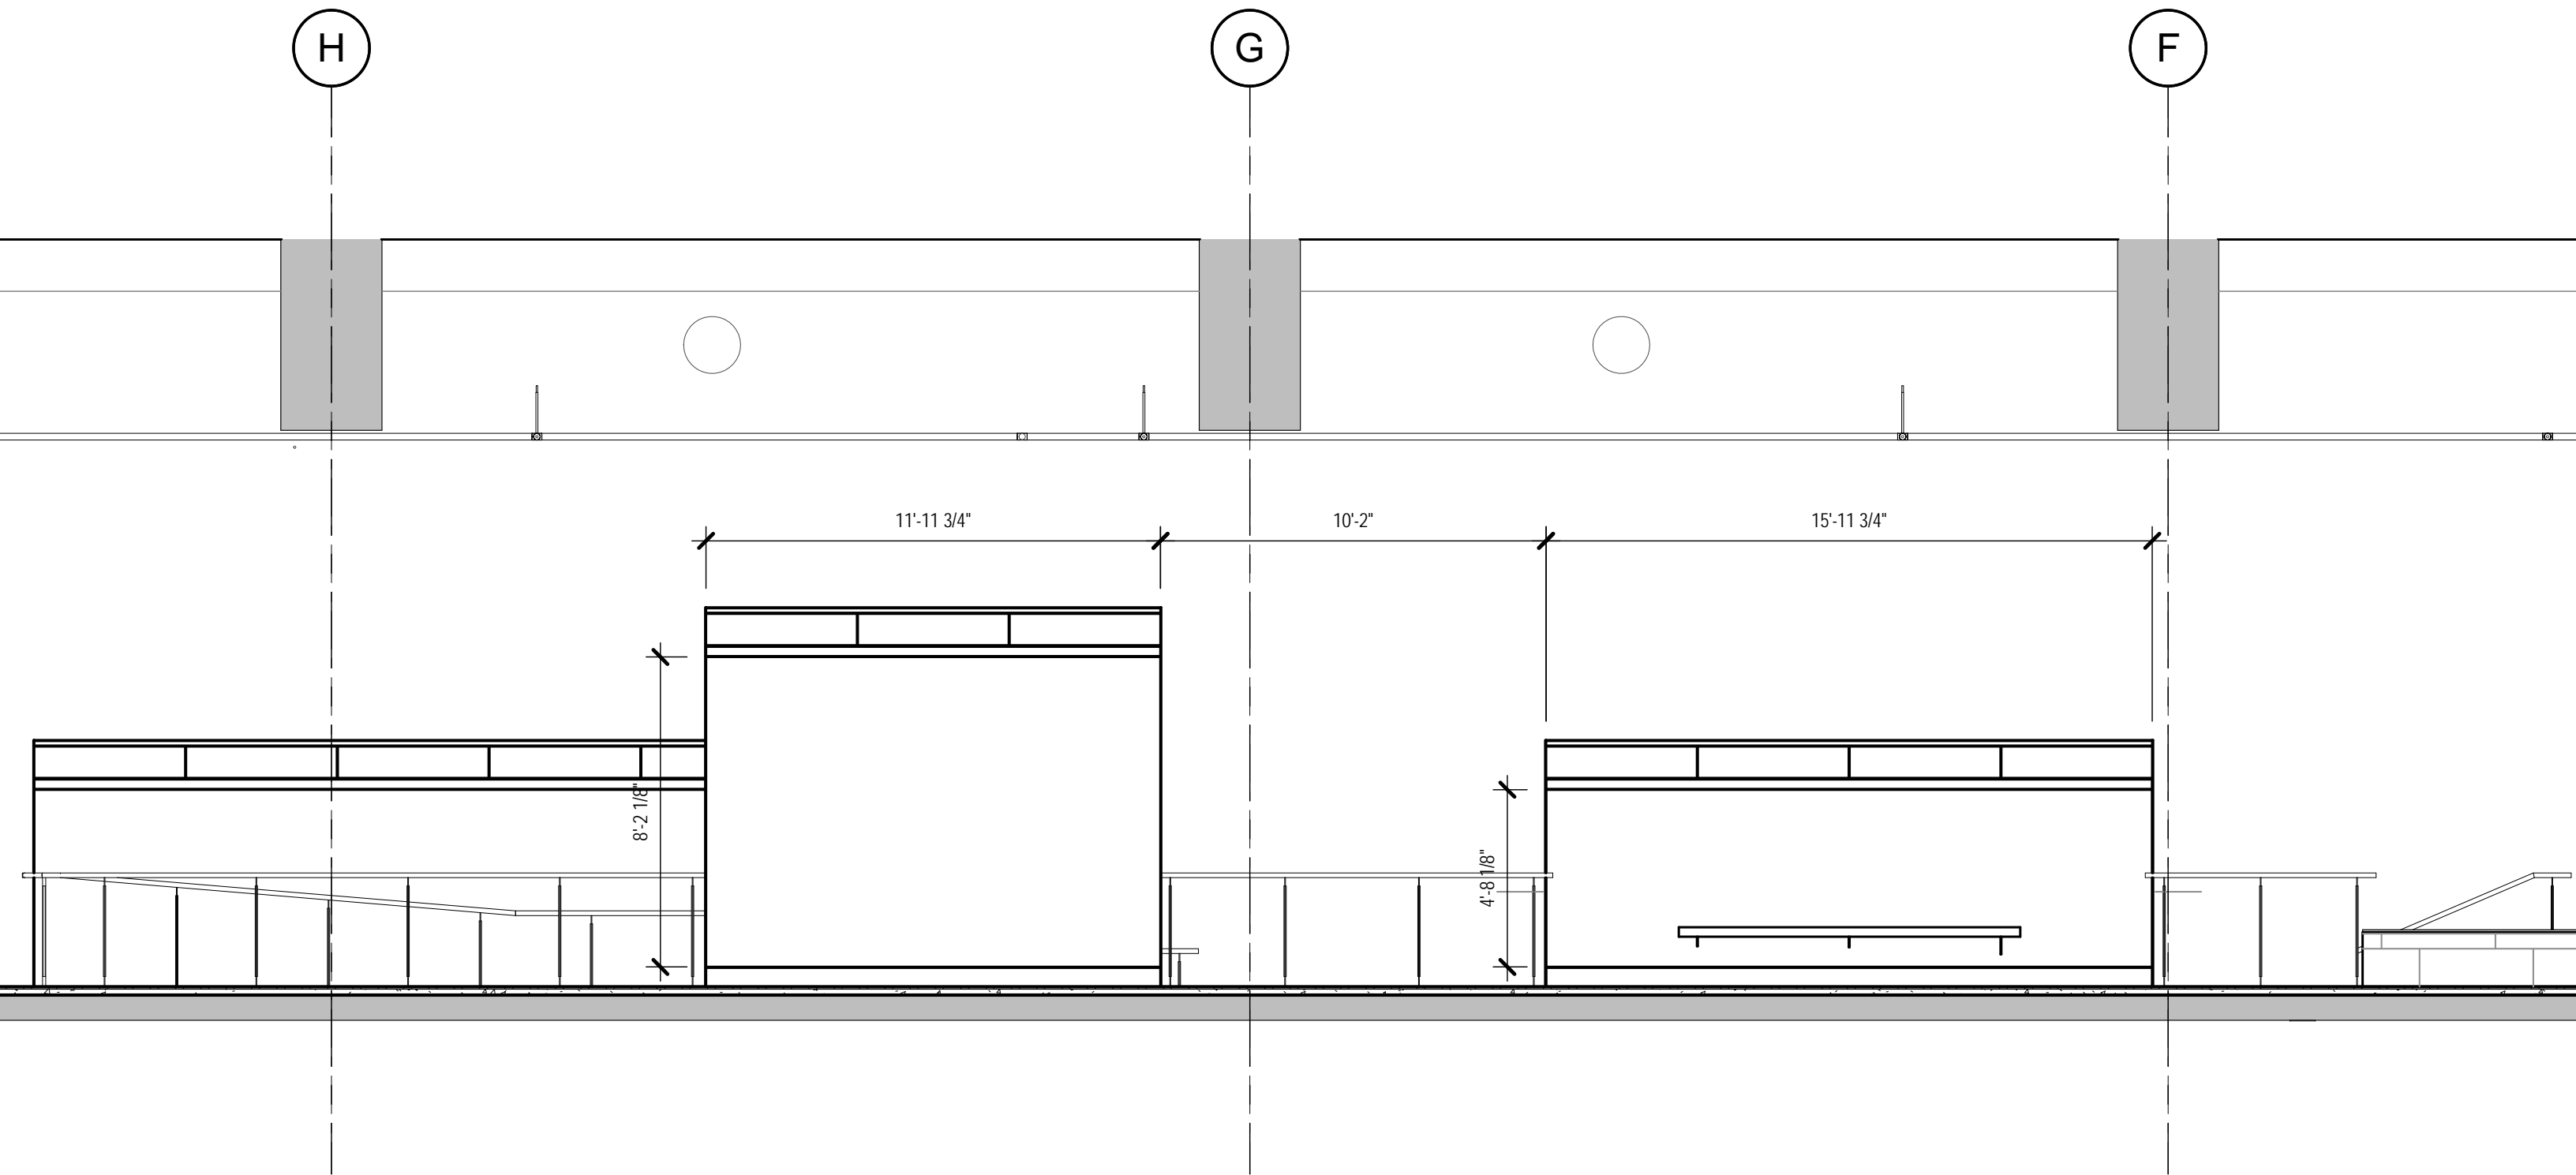


ELEVATION "C"

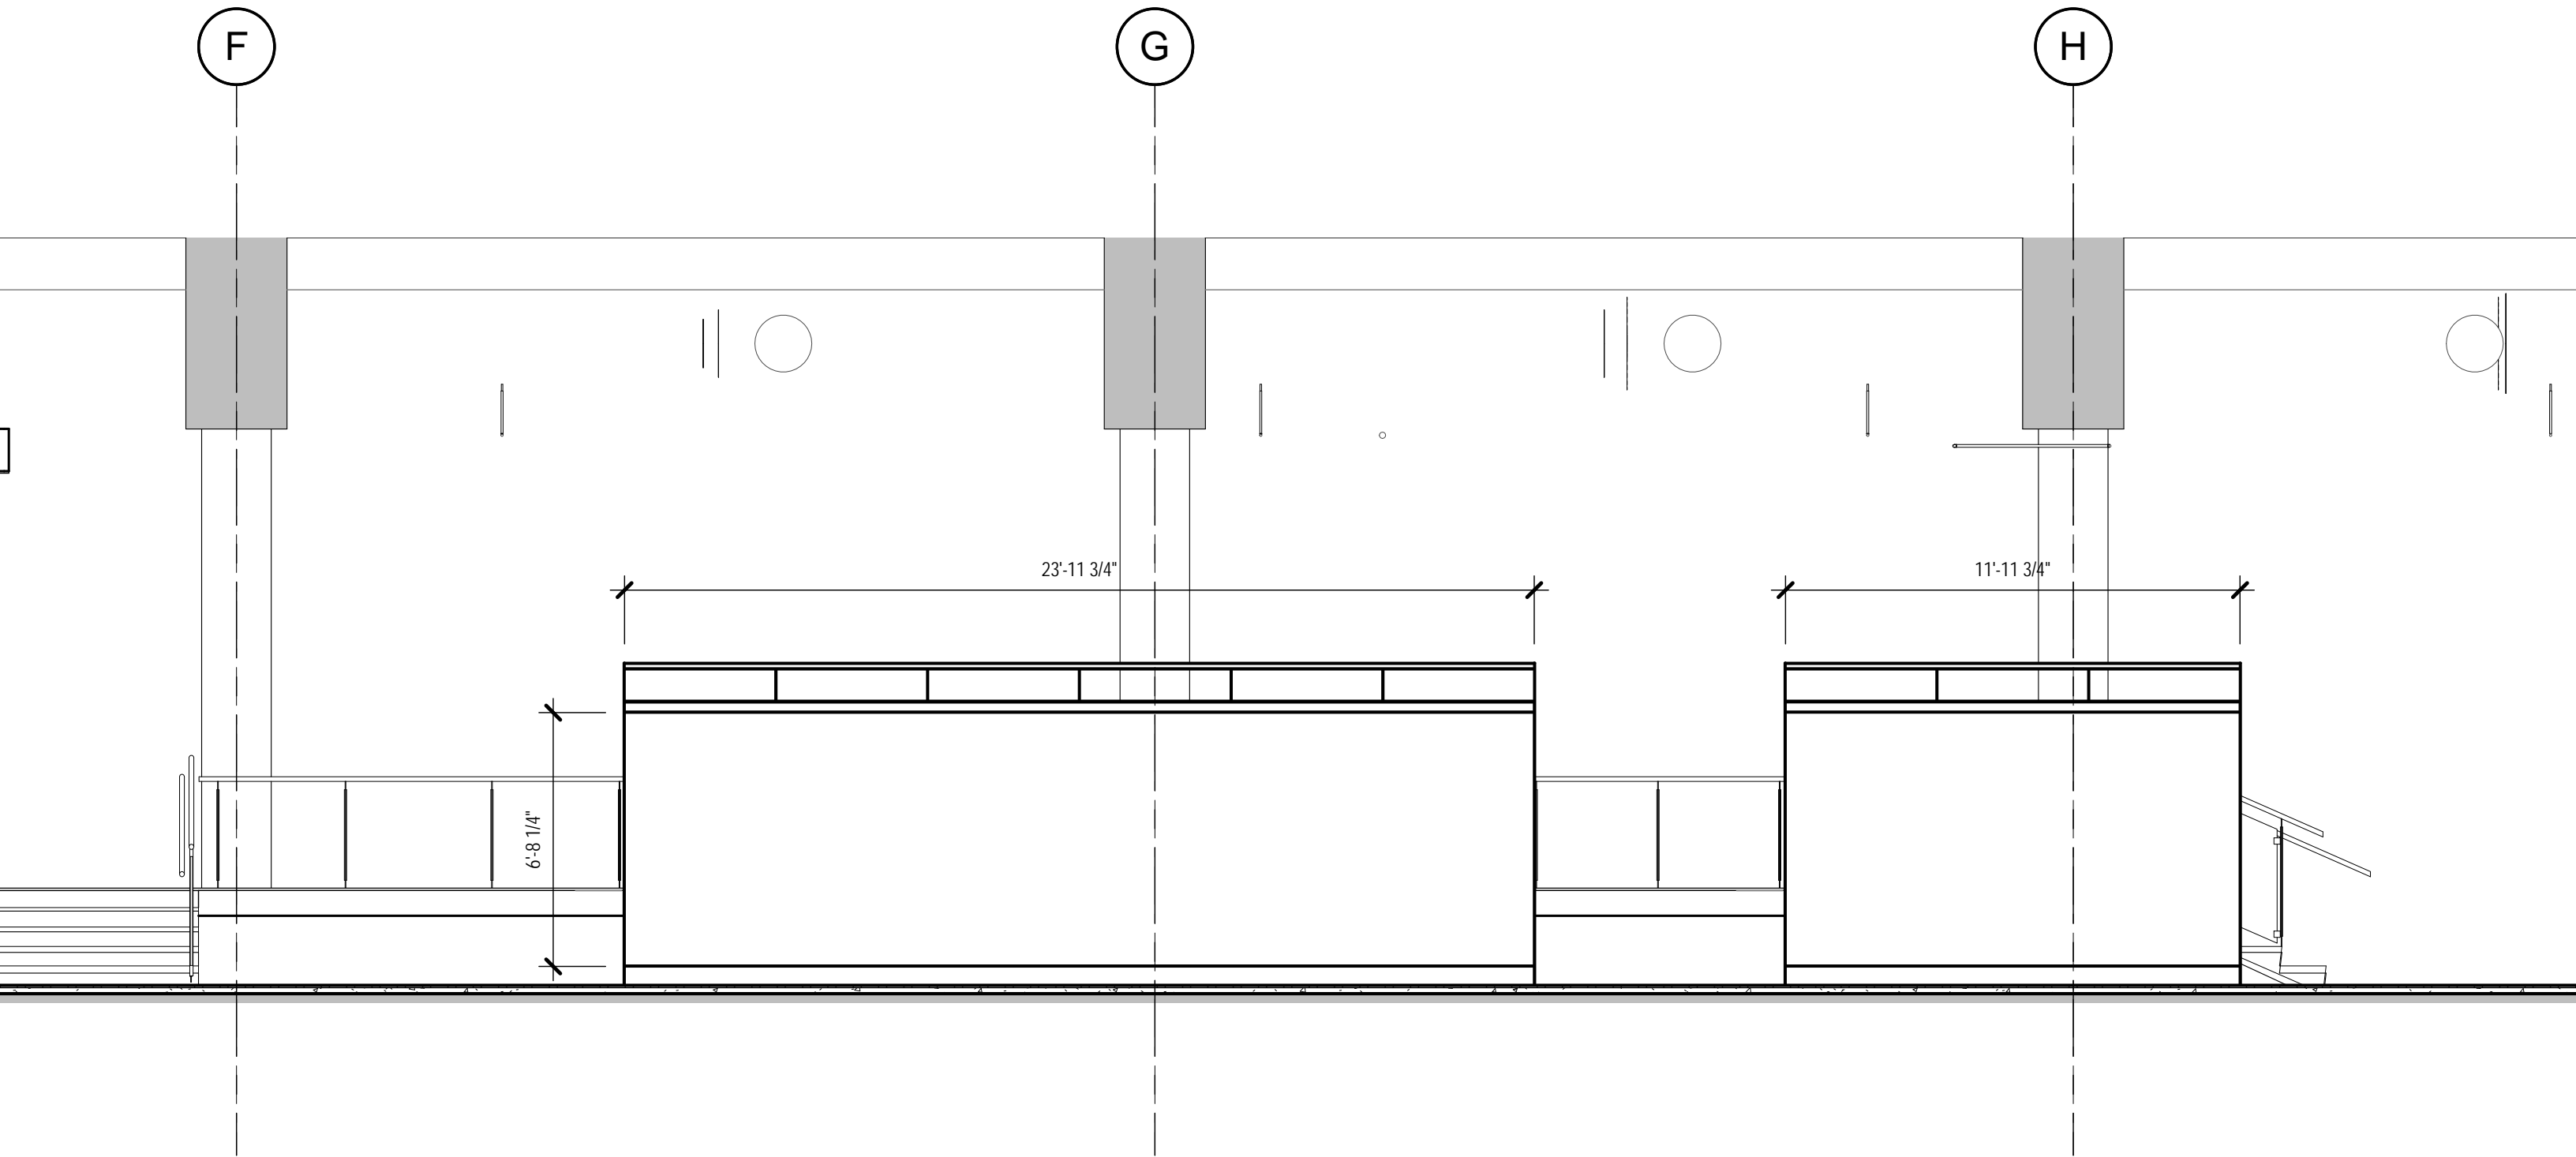


ELEVATION "D"

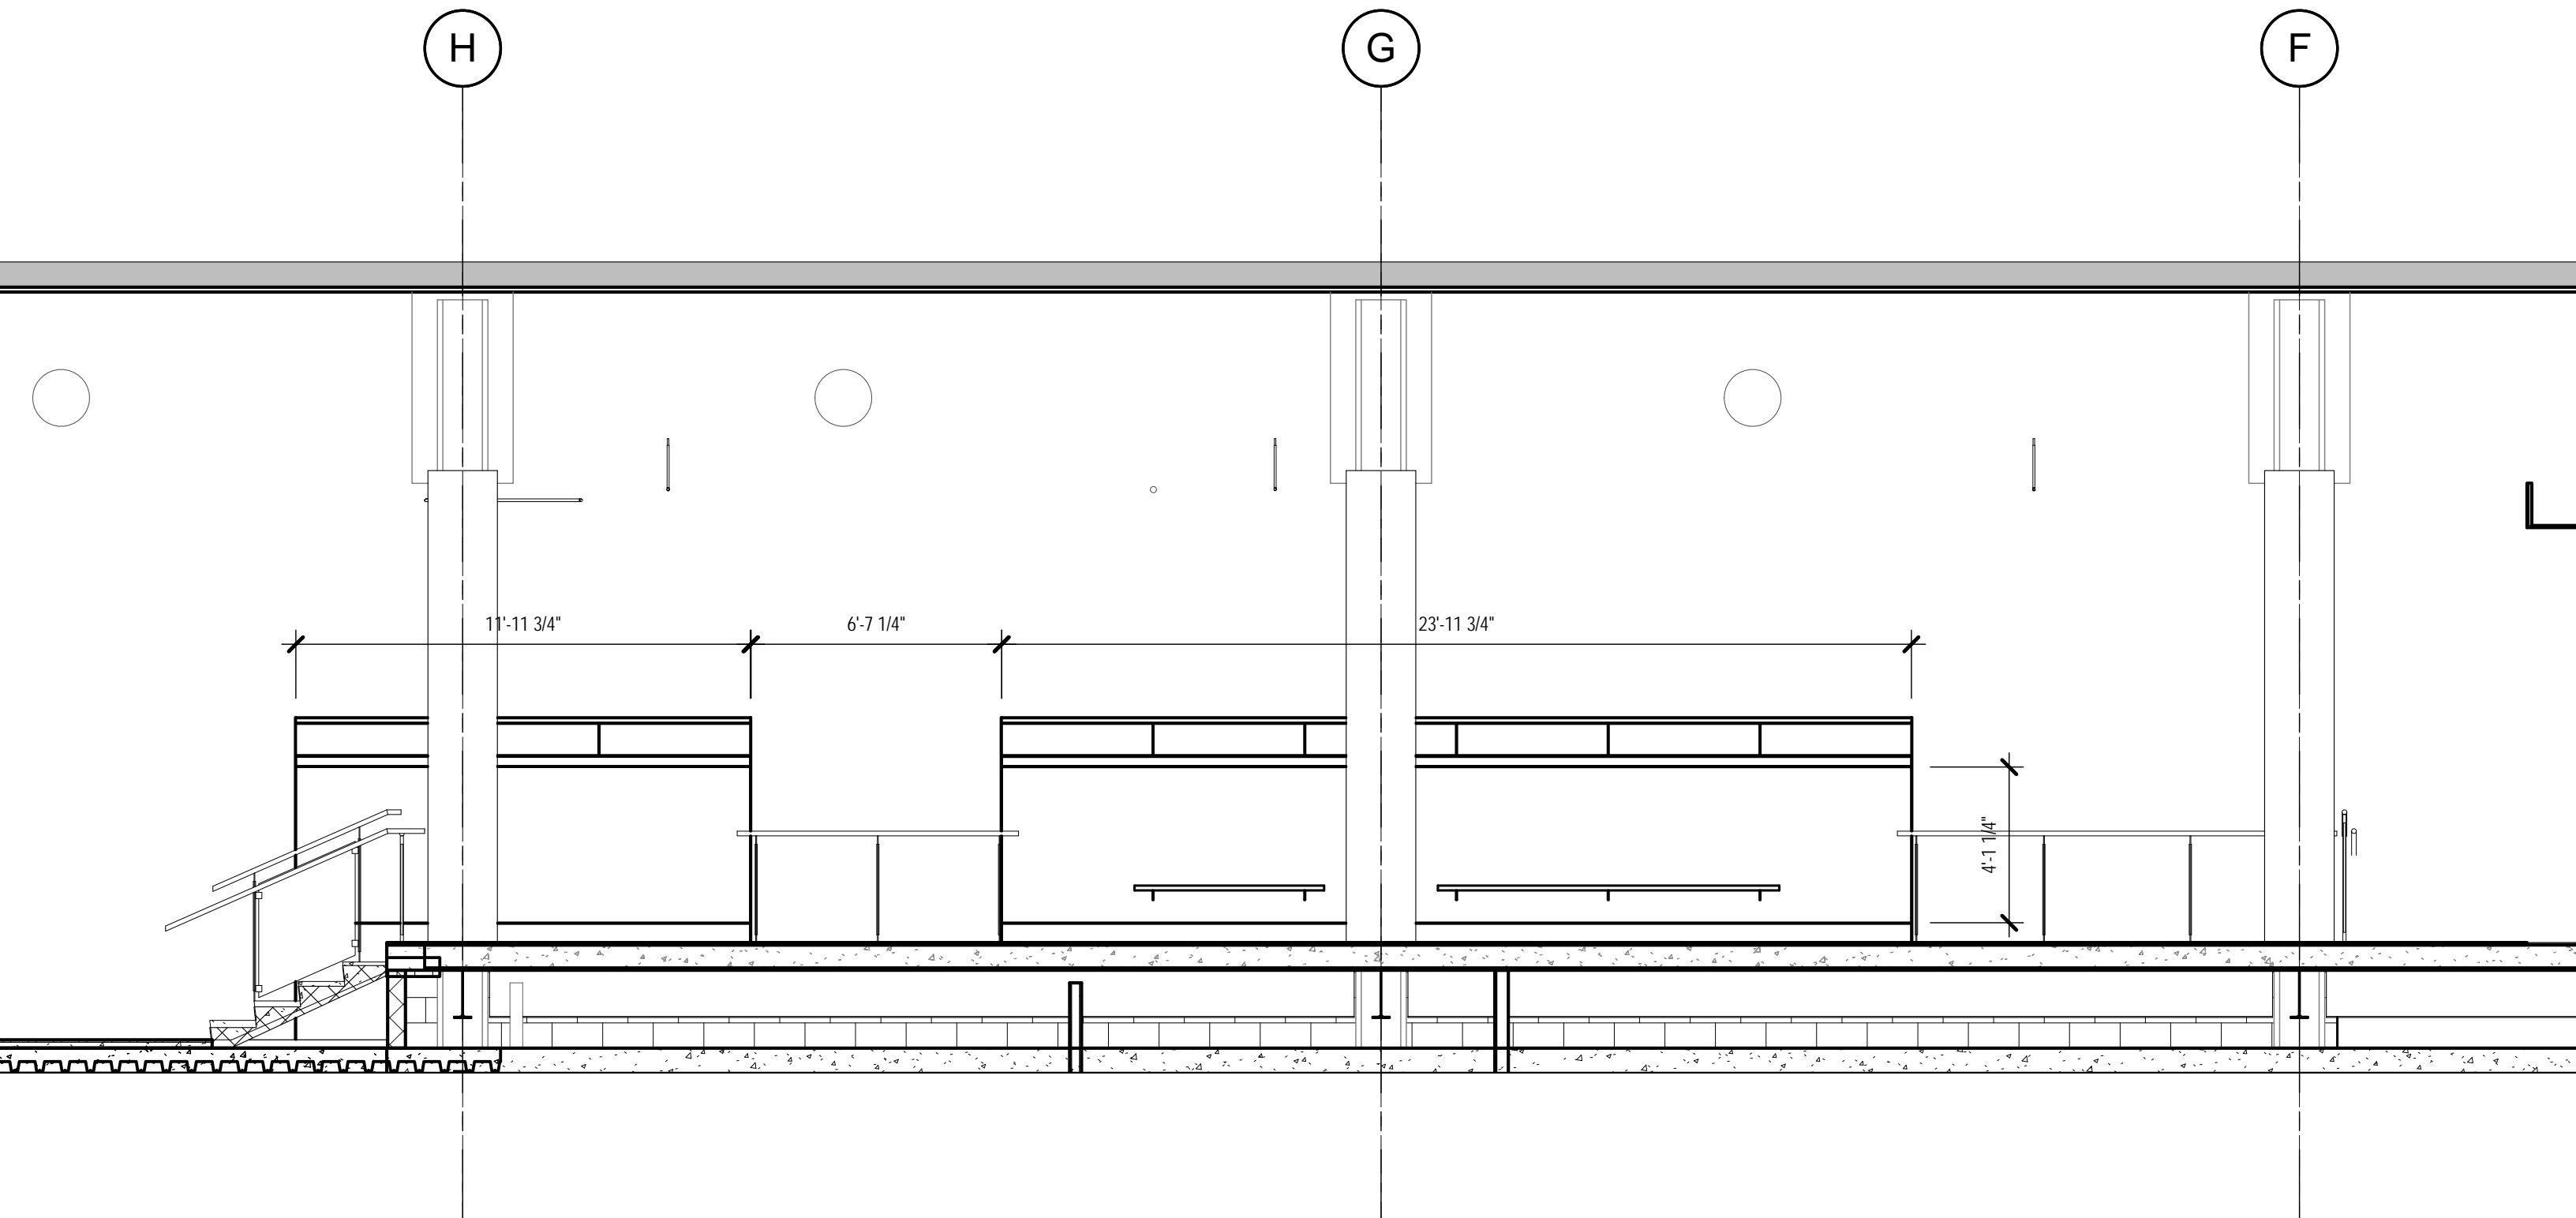

ELEVATION "E"

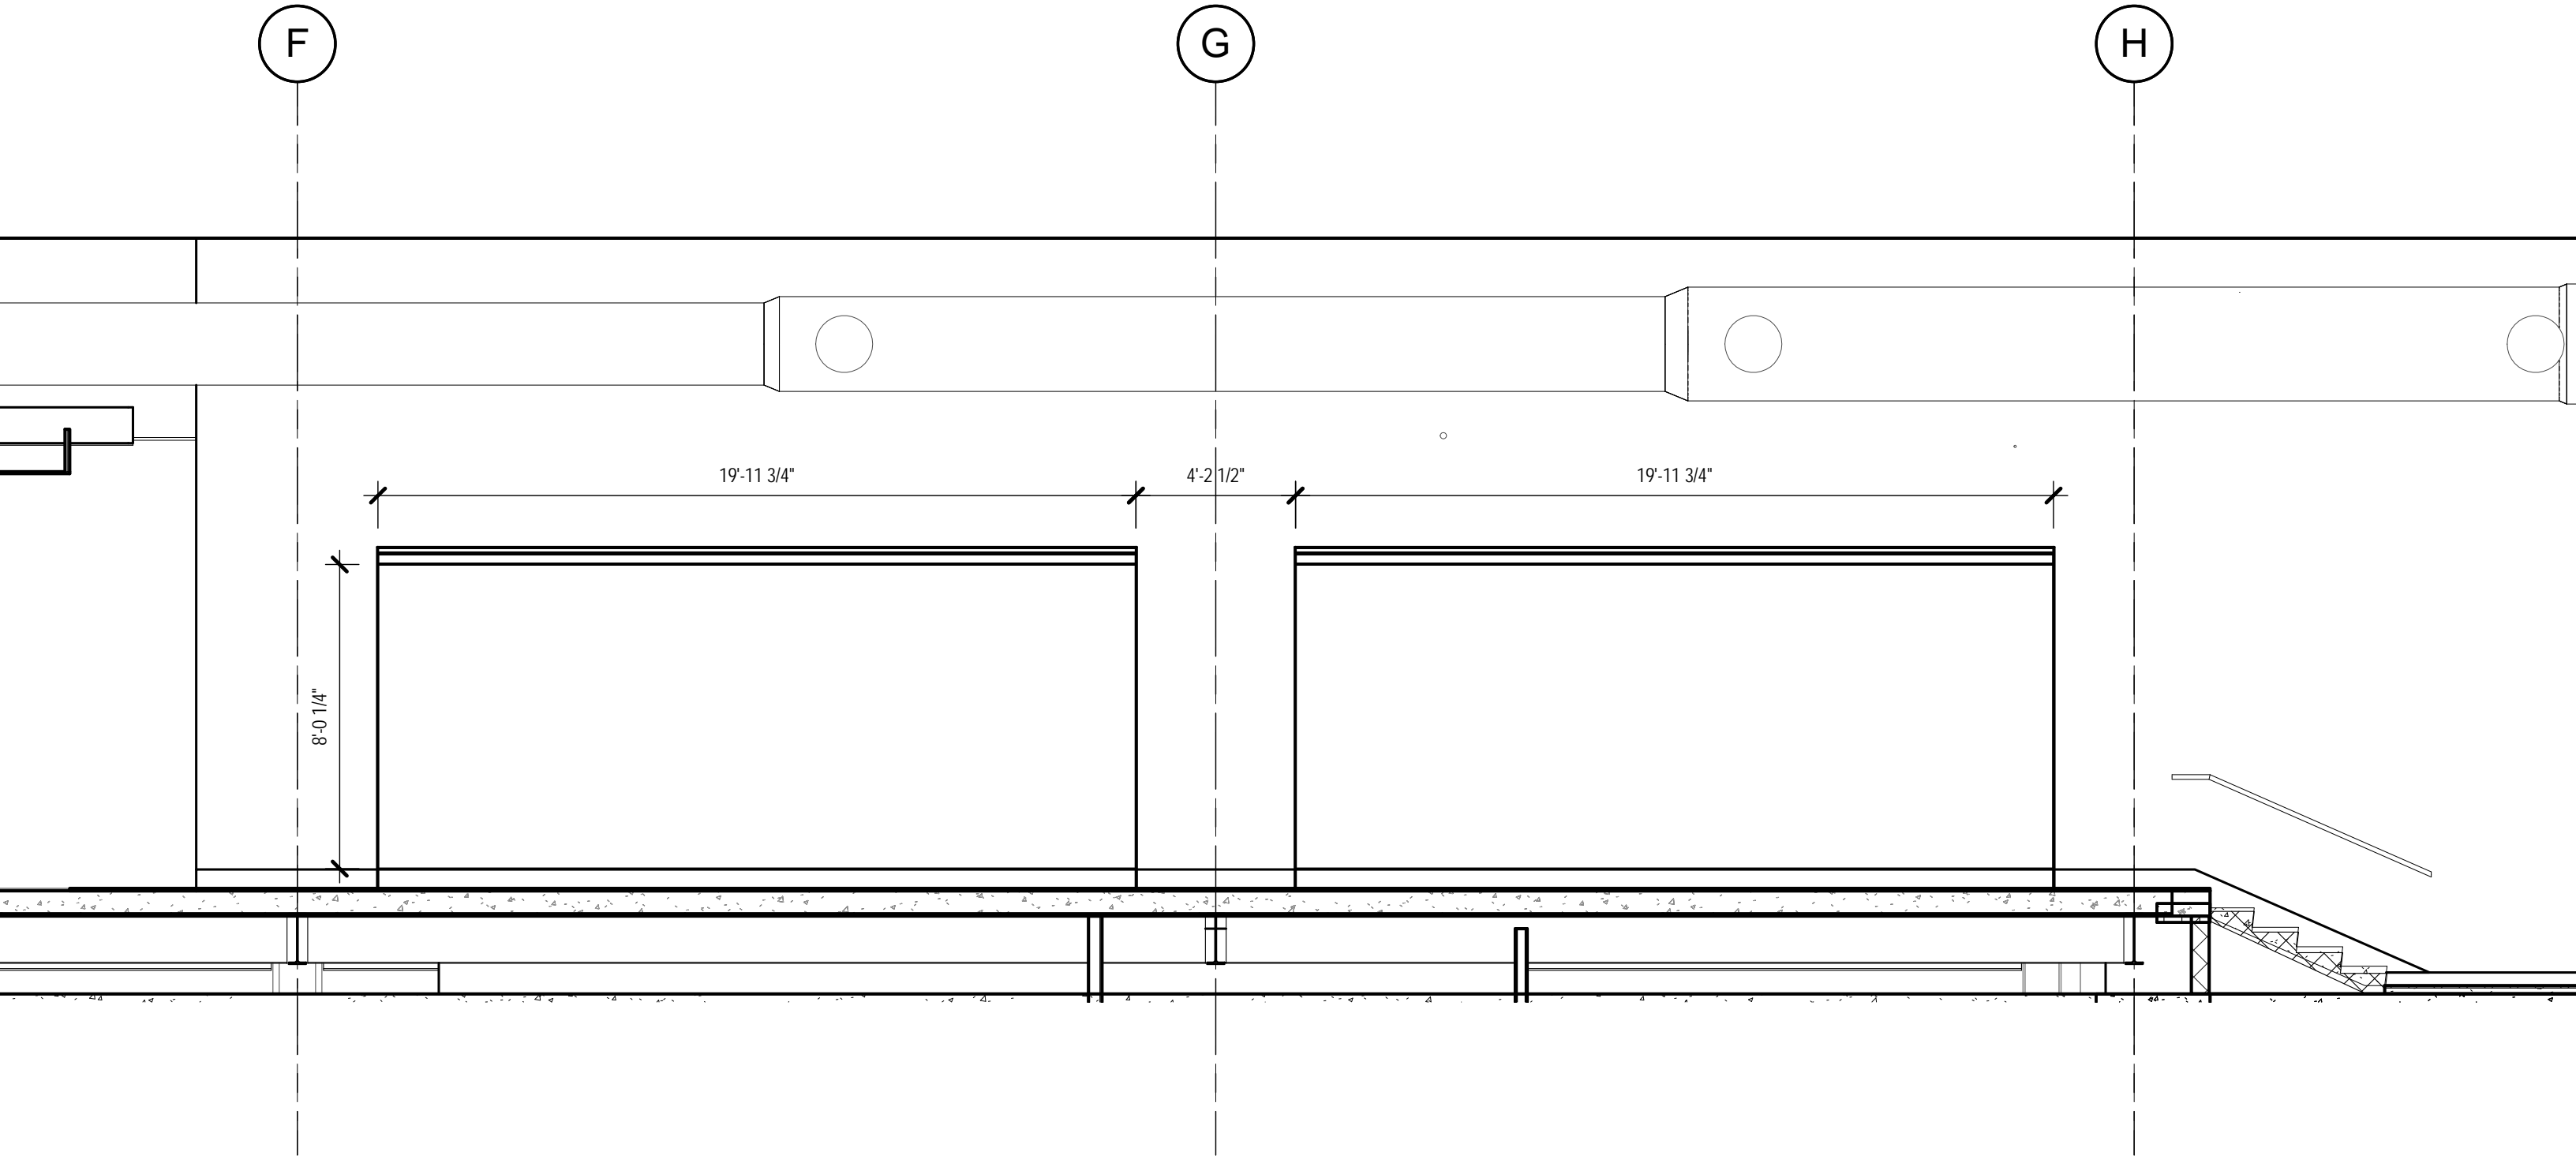

ELEVATION "F"

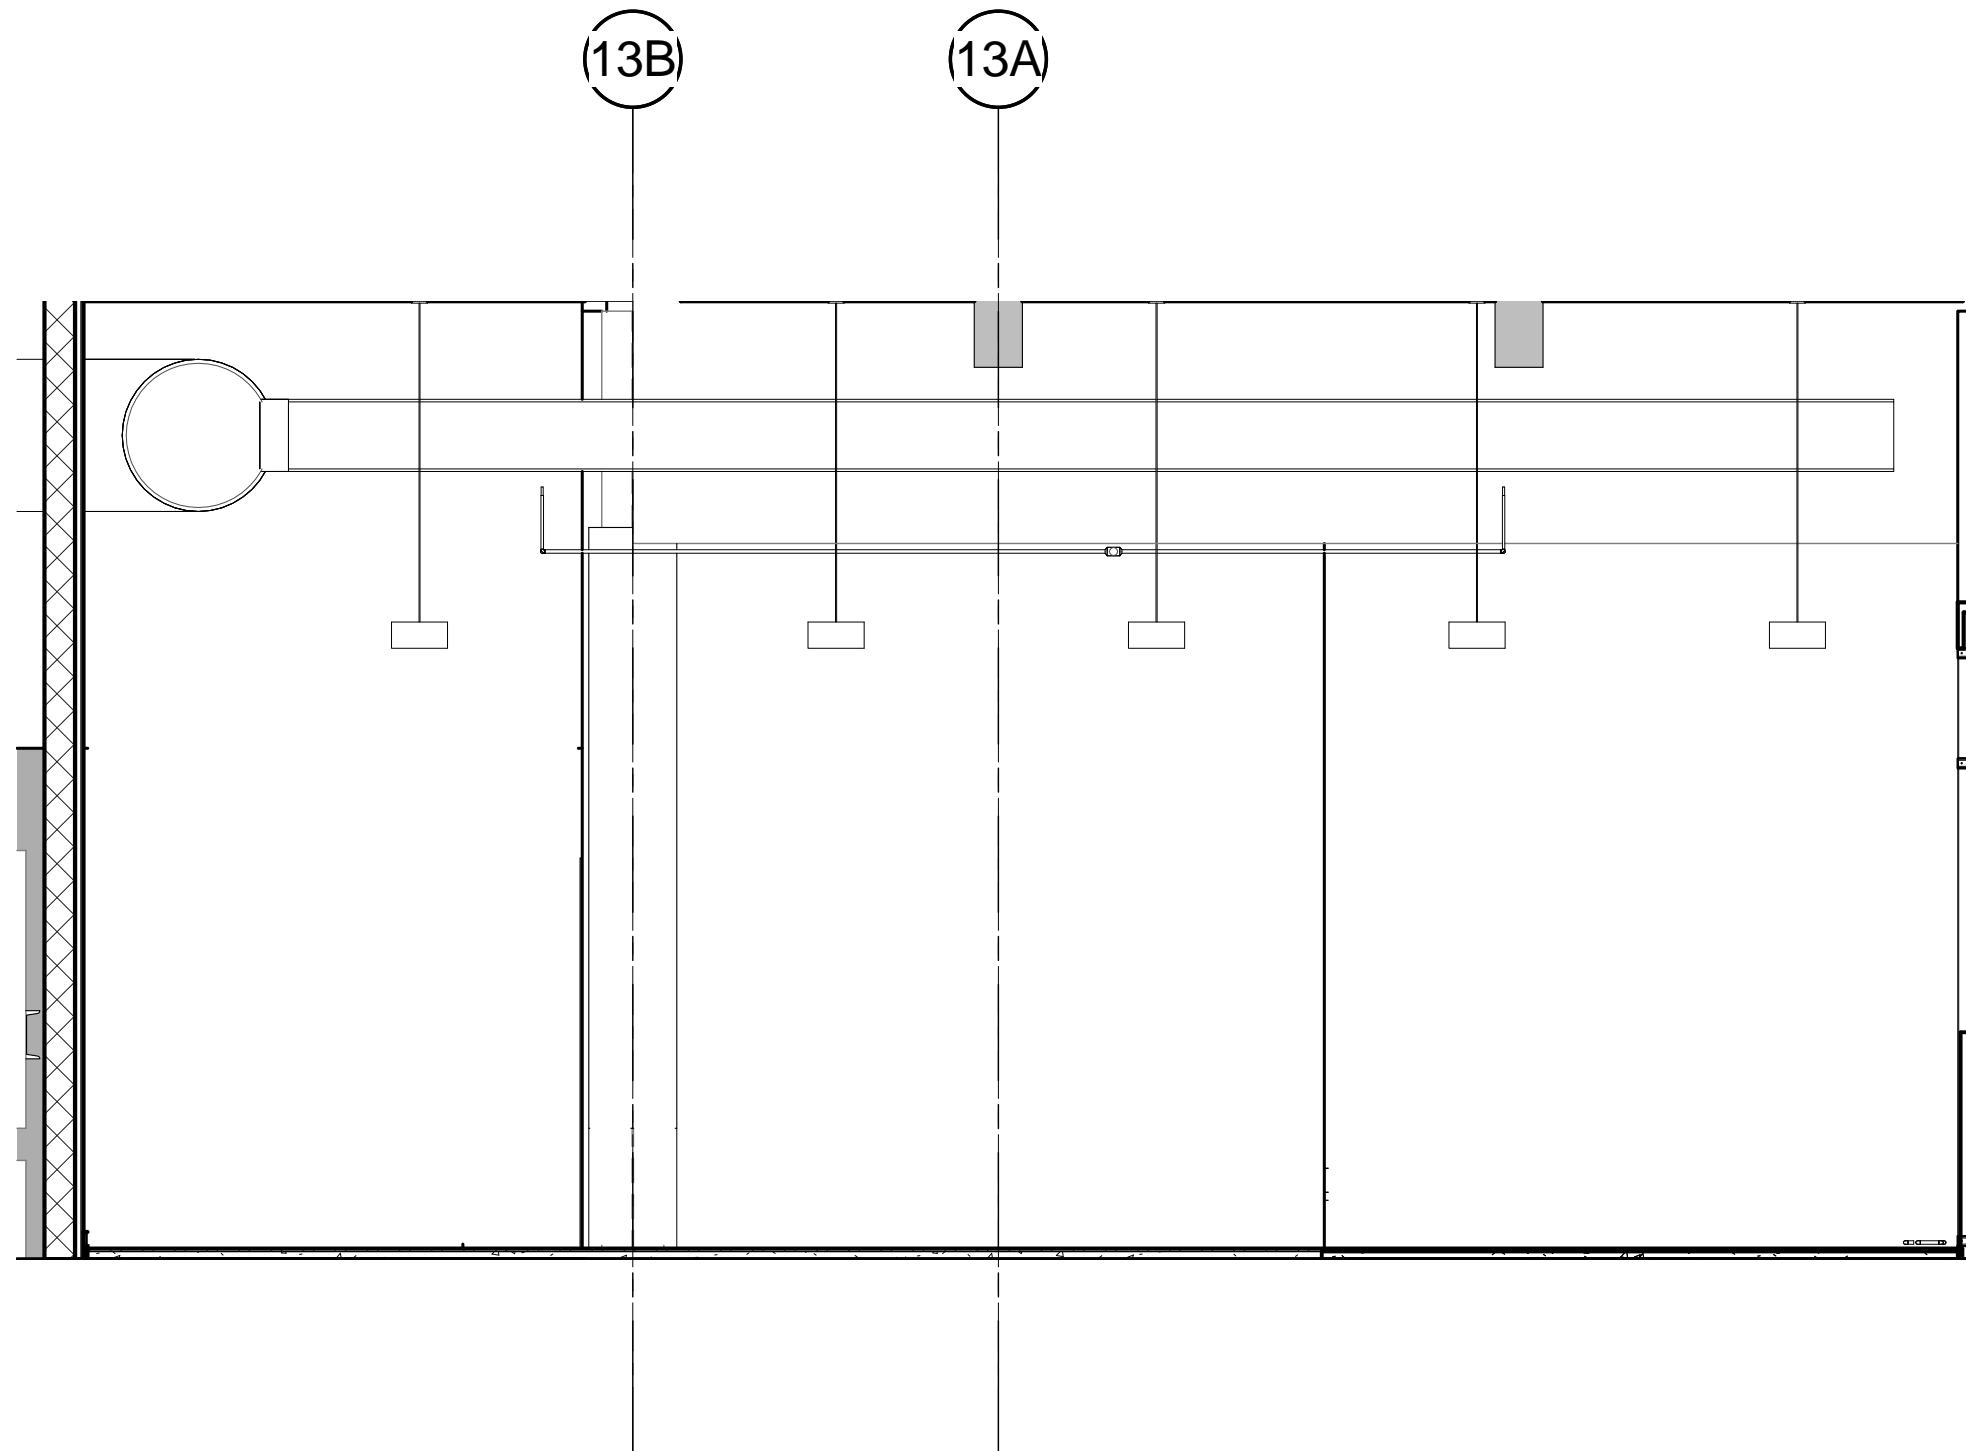

ELEVATION "G"