


Exhibit A

Wilson Aquatic Center Locker Plans Drawings

WILSON AQUATIC CENTER

OWNER: DEPARTMENT OF PARKS AND RECREATION, GOVERNMENT OF THE DISTRICT OF COLUMBIA
ADDRESS: 1480 GIRARD STREET, NW SUITE 420, WASHINGTON, D.C. 20010

PROJECT / OWNER

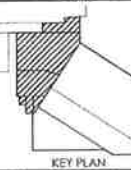

11.10.2007 O.U., E.F. & P.
02.28.2008 GMP SET
03.20.2008 ISSUED FOR PERMIT
05.14.2008 ADDENDUM #3
06.25.2008 100% CD'S


MARK DATE ISSUE
DRAWN BY: HB
CHECKED BY: MM
PROJECT NO: 0519
Copyright © 2008
by Hughes Group Architects

PARTIAL FLOOR PLANS:
BASEMENT LEVEL WEST
& LOWER LEVEL WEST


A-111

LOWER LEVEL ROOM KEY LEGEND	
NO.	NAME
E01	ELEV.
S01	STAIRS #1
S02	STAIRS #2
S03	STAIRS #3
101	LOBBY
102	VEST.
103	M. VEST.
104	MEN'S LOCKER ROOMS
105	CORR.
106	M. TOIL.
107	M. SHOWERS
108	W. VEST.
109	W. TOIL.
110	W. CORR.
111	W. SHOWERS
112	W. LOCKERS
113	JAN.
114	ELEV. EQUIP.
115	FAMILY LOCKER
116	FAMILY #1
117	FAMILY #2
118	FAMILY #3
119	FAMILY #4
120	STAFF LOCKERS
121	TOIL.
122	OFFICE
123	SAFETY CENTER
124	COMPETITION POOL
125	POOL STOR.
126	M. POOL VEST.
127	BACKFLOW PREVENTERS
129	LEISURE POOL
130	ADULT WHIRLPOOL
131	MEET OFFICE
133	ELEC.
134	POOL STOR.
135	VALVE ROOM
136	ELECTRIC ROOM
137	CHLORINE ROOM
138	ACID ROOM
139	SPRINKLER ROOM
140	WATER ROOM
141	W. POOL VEST.
142	POOL DECK
143	ELECTRIC CLOSET

THIRD PARTY PLAN REVIEW CERTIFICATION
I, the undersigned, being duly licensed and qualified, have reviewed the above referenced plans and certify that they conform to the applicable provisions of the applicable laws, codes and regulations, and that the plans are complete and correct for the purposes for which they are intended.
Date: 7/8/08
Signature: [Signature]
Professional Seal: [Seal]

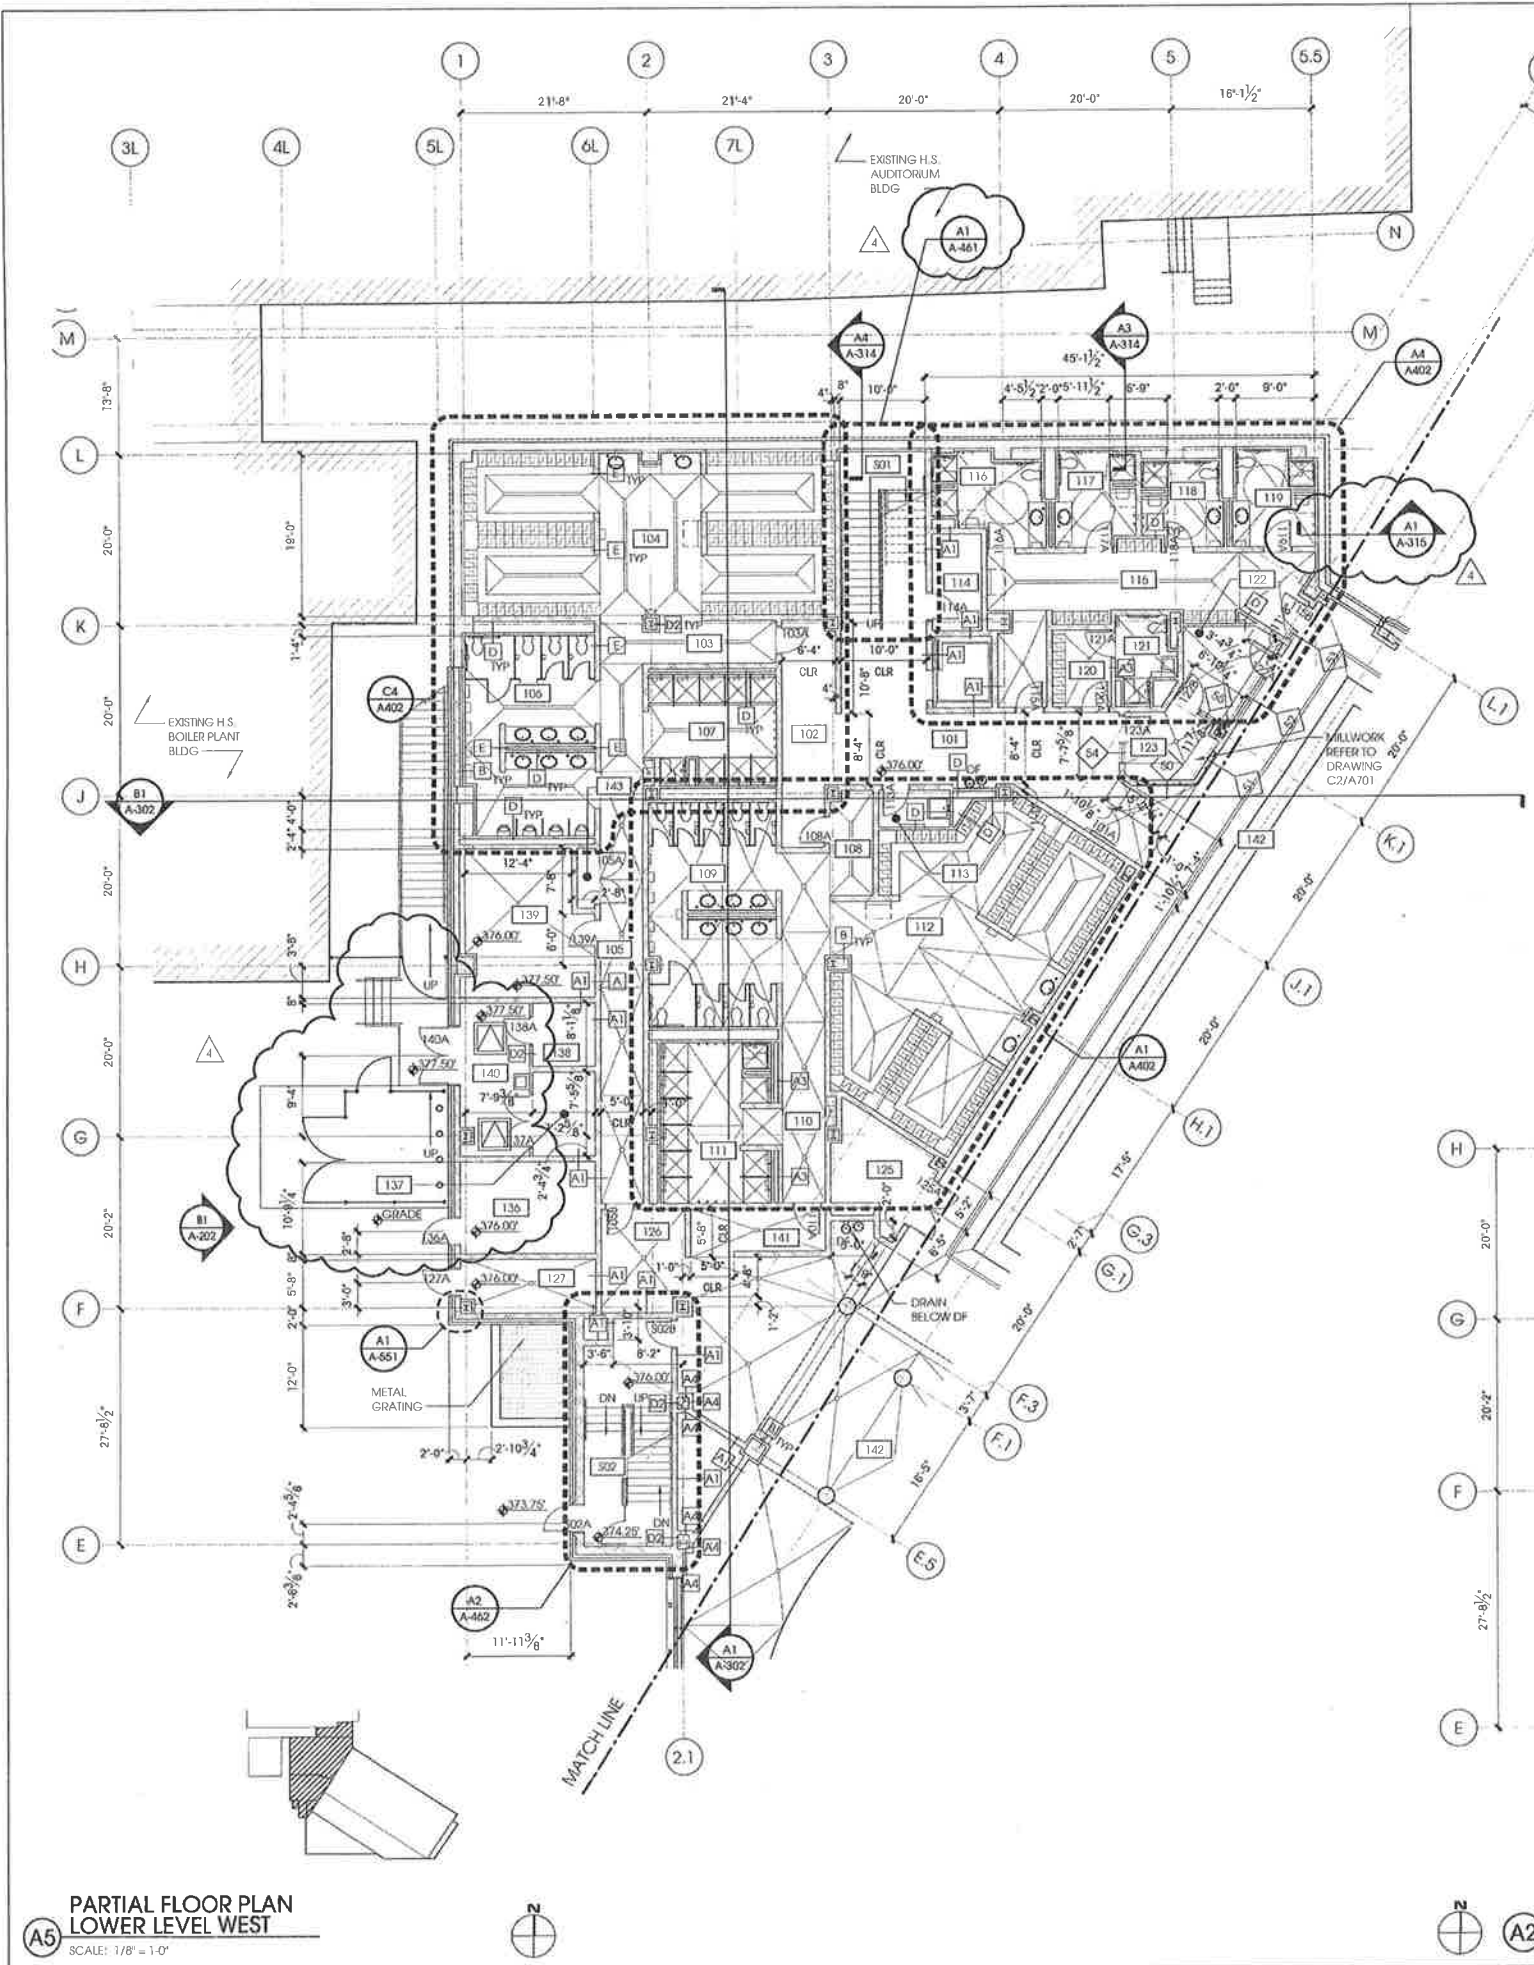

**PARTIAL FLOOR PLAN
LOWER LEVEL WEST**
SCALE: 1/8" = 1'-0"

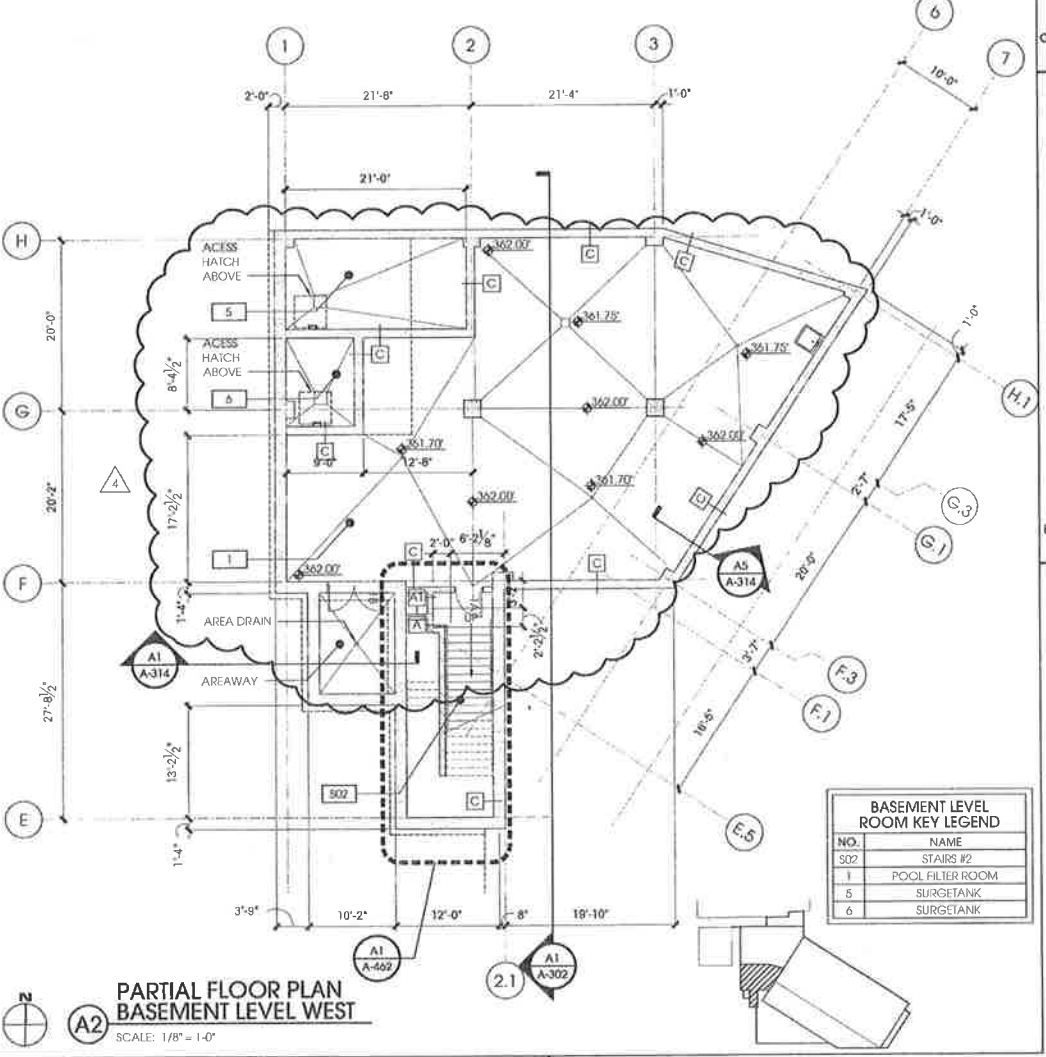

**PARTIAL FLOOR PLAN
BASEMENT LEVEL WEST**
SCALE: 1/8" = 1'-0"

BASEMENT LEVEL ROOM KEY LEGEND	
NO.	NAME
S02	STAIRS #2
1	POOL FILTER ROOM
5	SURGETANK
6	SURGETANK

WILSON AQUATIC CENTER

OWNER: DEPARTMENT OF PARKS AND RECREATION, GOVERNMENT OF THE DISTRICT OF COLUMBIA
ADDRESS: 1480 GIRARD STREET, NW SUITE 420, WASHINGTON, D.C. 20010

PROJECT / OWNER




KEY PLAN

11.10.2007	O, U, E, F, & P,
02.28.2008	GNP SET
03.20.2008	ISSUED FOR PERMIT
03.18.2008	ADDENDUM #1
05.14.2008	ADDENDUM #3
06.25.2008	100% CDS

MARK	DATE	ISSUE
DRAWN BY: HB		
CHECKED BY: NM		
PROJECT NO: 0519		
Copyright © 2008 by Hughes Group Architects		

ENLARGED
PARTIAL
FLOOR PLANS
TOILET ACCESSORIES


A-401

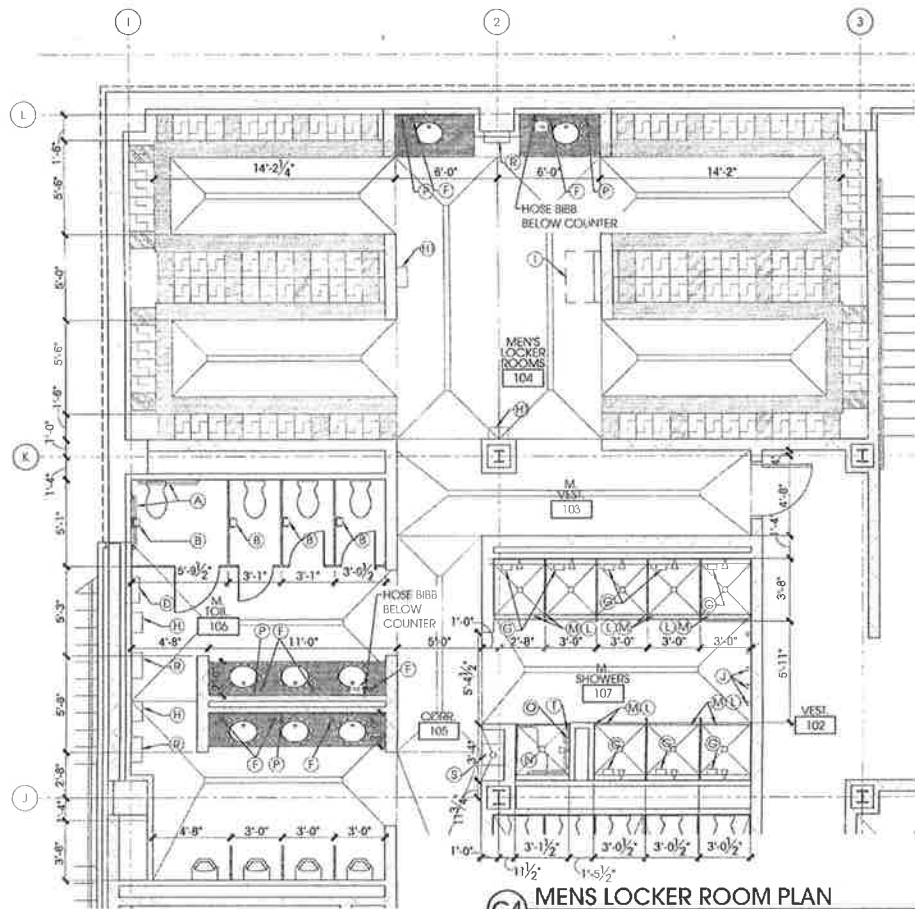

C4 MENS LOCKER ROOM PLAN

SCALE: 1/4" = 1'-0"

NOTE: REFER TO SHEET A-402 FOR ALL DRAIN LOCATIONS AND SLOPE INFORMATION.

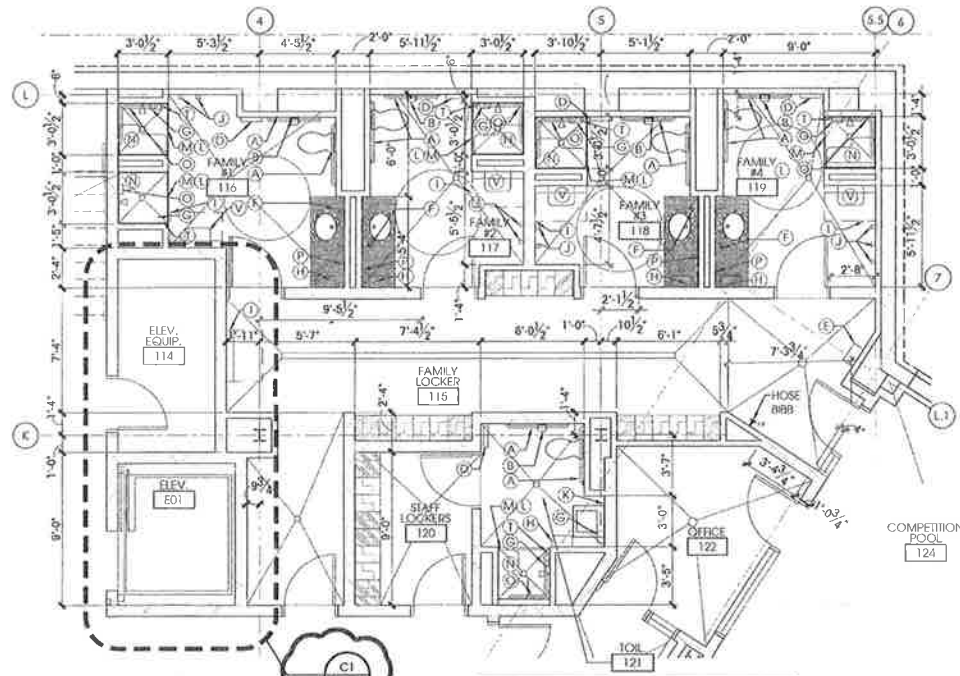

A4 FAMILY CABANAS PLAN

SCALE: 1/4" = 1'-0"


NOTE: REFER TO SHEET A-402 FOR ALL DRAIN LOCATIONS AND SLOPE INFORMATION.

ENLARGED LOCKER ROOM PLAN LEGEND

SYMBOL	DESCRIPTION
[Symbol]	TYPICAL TWO TIER LOCKER UNIT (1 LOCKER UNIT = 2 STACKED LOCKERS)
[Symbol]	TYPICAL TWO TIER LOCKER UNIT W/ ACCENT COLOR (1 LOCKER UNIT = 2 STACKED LOCKERS)

LOCKER QUANTITY		
NO. OF TWO TIER UNITS	ROOM NUMBER	ROOM NAME
129	104	MEN'S LOCKER ROOMS
115	112	WOMEN'S LOCKERS
17	115	FAMILY LOCKERS
8	120	STAFF LOCKERS
TOTAL QUANTITY OF TWO TIER LOCKER UNITS: 269		

GENERAL NOTES:
1. REFER TO A-403 FOR TOILET ACCESSORY SCHEDULE.

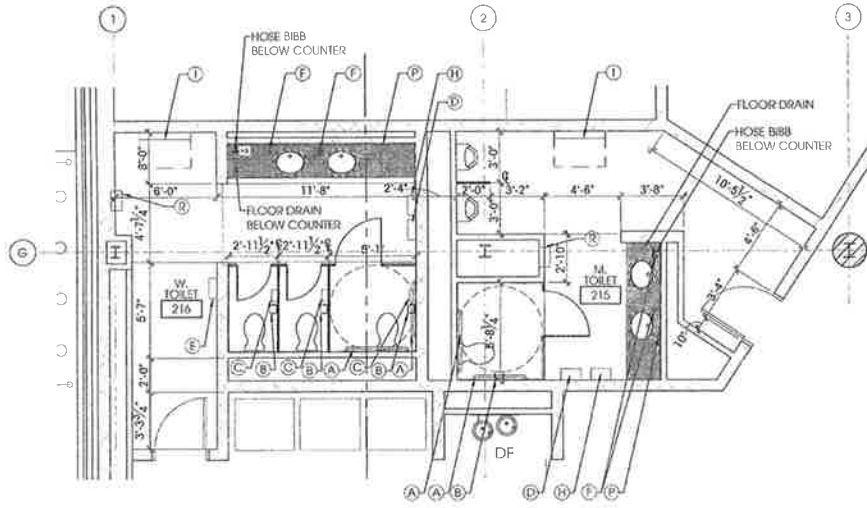


C1 UPPER LEVEL TOILET PLAN

SCALE: 1/4" = 1'-0"

NOTE: REFER TO SHEET A-402 FOR ALL DRAIN LOCATIONS AND SLOPE INFORMATION.

THIRD PARTY PLANS REVIEW CERTIFICATION
These plans and supporting applications have been reviewed for compliance with the 2005 DC Construction Code and as the best of our knowledge and belief, the plans comply with the applicable provisions of the code. This certification is not a representation of the quality of the work or the performance of the contractor. It is not a warranty of any kind and is not intended to be a part of the contract documents.
Reviewed: [Signature]
Reviewed: [Signature]
Reviewed: [Signature]

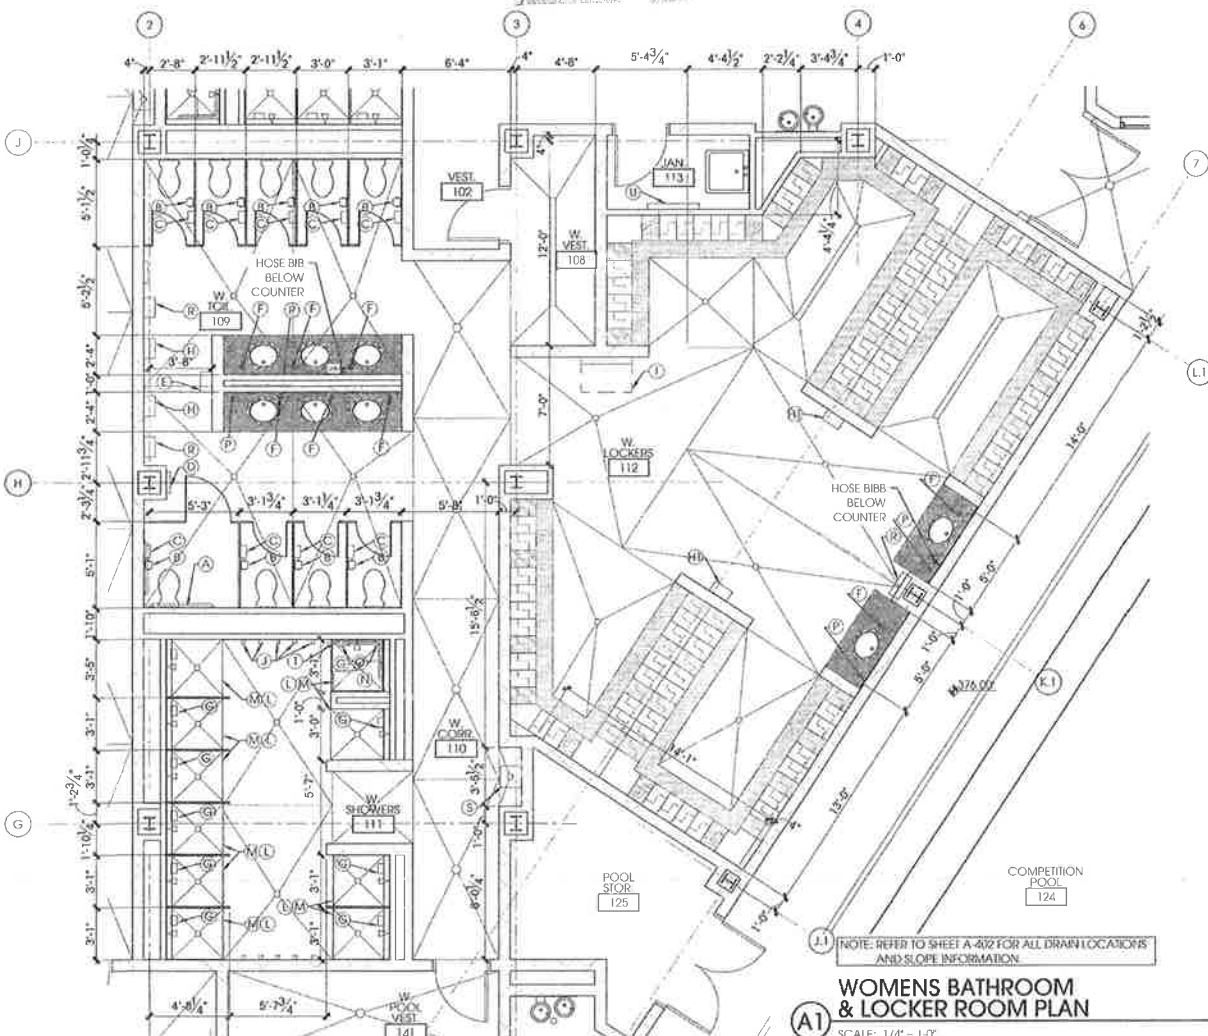

A1 WOMENS BATHROOM & LOCKER ROOM PLAN

SCALE: 1/4" = 1'-0"

NOTE: REFER TO SHEET A-402 FOR ALL DRAIN LOCATIONS AND SLOPE INFORMATION.



OWNER: DEPARTMENT OF PARKS AND RECREATION, GOVERNMENT OF THE DISTRICT OF COLUMBIA
ADDRESS: 1480 GIRARD STREET, NW SUITE 420, WASHINGTON, D.C. 20010

KEY PLAN

11.10.2007	O. U., E. F. & P.
02.28.2008	GMP SET
03.20.2008	ISSUED FOR PERM
03.18.2008	ADDENDUM #1
05.14.2008	ADDENDUM #3
06.25.2008	100% CD'S


MARK	DATE	ISSUE
------	------	-------

DRAWN BY: HB
CHECKED BY: MM
PROJECT NO: 0519

Copyright © 2008
by Hughes Group Architects

ENLARGED
FLOOR DRAIN
PLANS @ LOCKERS

A-402

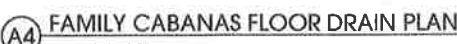

WILSON AQUATIC CENTER

OWNER: DEPARTMENT OF PARKS AND RECREATION, GOVERNMENT OF THE DISTRICT OF COLUMBIA
ADDRESS: 1480 GIRARD STREET, NW SUITE 420, WASHINGTON, D.C. 20010

PROJECT / OWNER




11.10.2007 O. U., E. F. & P.
02.28.2008 GMP SET
03.20.2008 ISSUED FOR PERMIT

06.25.2008 100% CD'S


MARK DATE ISSUE
DRAWN BY: ARS
CHECKED BY: ARS
PROJECT NO: 0519
Copyright © 2008
by Hughes Group Architects

LOCKER ROOM DETAILS
AND FLOOR DRAIN
DETAILS

A-404

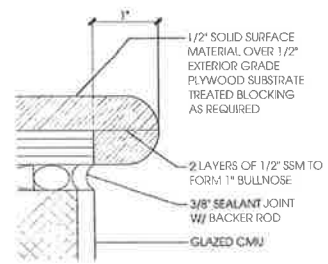


D5 SSM SEAT EDGE DETAIL
SCALE: 1'-0" = 1'-0"

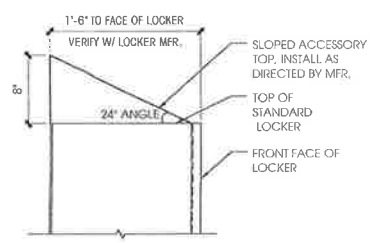


C5 SLOPED LOCKER TOP ACCESSORY ELEVATION, TYP
SCALE: 1 1/2" = 1'-0"


NOTE: C/C OPTION, PROVIDE RIGID INSULATION IN VOIDS TO SUPPORT CONCRETE IN PLACE OF METAL DECK

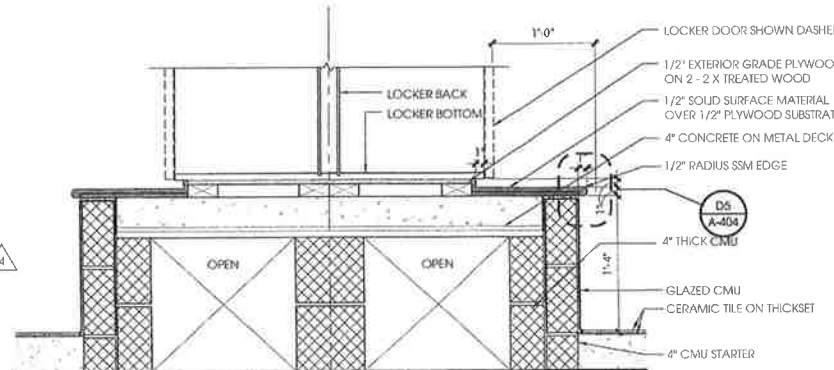

D3 TYPICAL LOCKER BASE
SCALE: 1 1/2" = 1'-0"

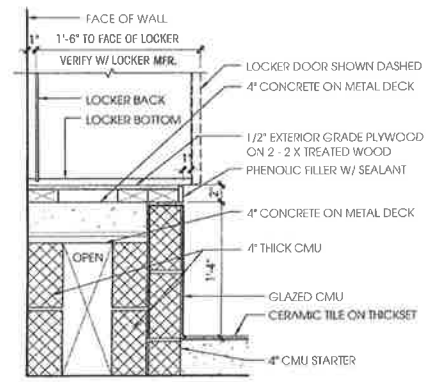


C4 TYPICAL LOCKER BASE WITHOUT SEAT
SCALE: 1 1/2" = 1'-0"

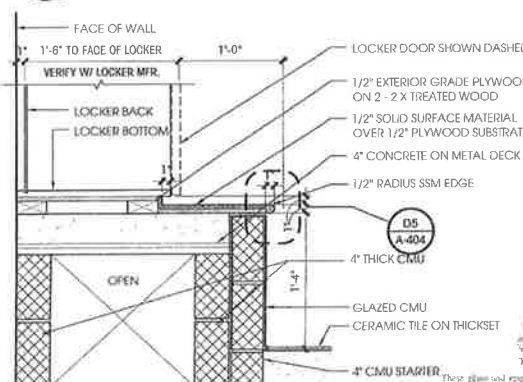


C3 TYPICAL LOCKER BASE
SCALE: 1 1/2" = 1'-0"


Sehlo, Bello & Associates, LLC
Sealing, Insulating, Waterproofing and Foundation
500 15th St., NW, Suite 1000
Washington, DC 20004
THIRD PARTY PLANS REVIEW/CONFIRMATION
These plans and supporting application have been reviewed and the compliance with the 2010 DC Construction Code and the local all use knowledge and building code. The plans comply with the applicable provisions of the code. Compliance and inspection review of the application for the following description is recommended for approval.
Date: 7/13/08
Signature: [Signature]
Title: [Title]

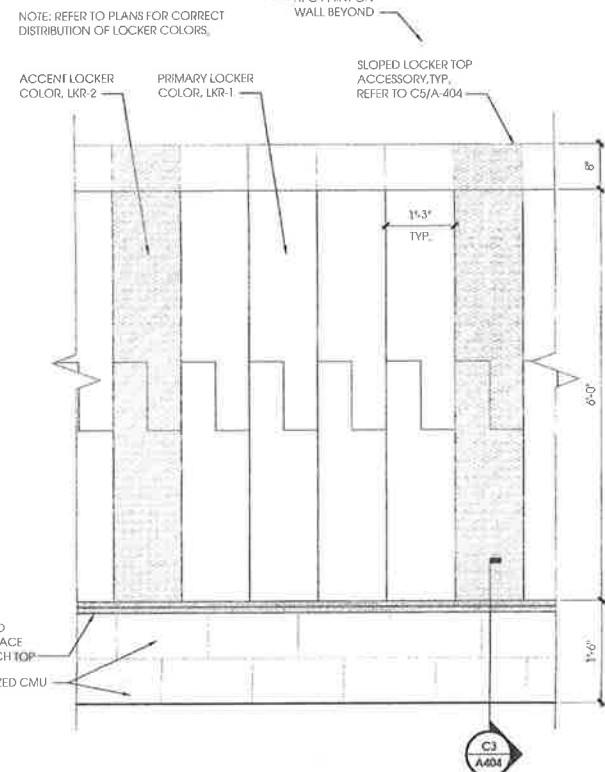


C1 TWO TIER LOCKER ELEVATION
SCALE: 1" = 1'-0"

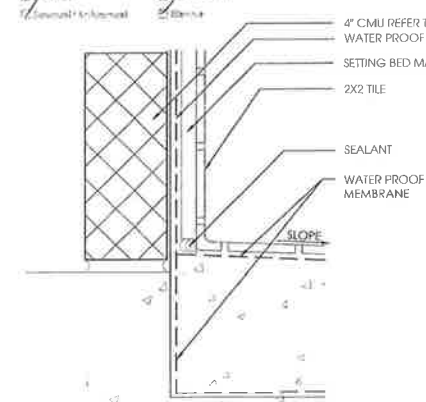


B2 SHOWER DETAIL
SCALE: 6" = 1'-0"

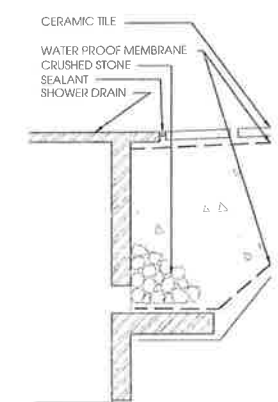


B1 SHOWER DETAIL
SCALE: 6" = 1'-0"

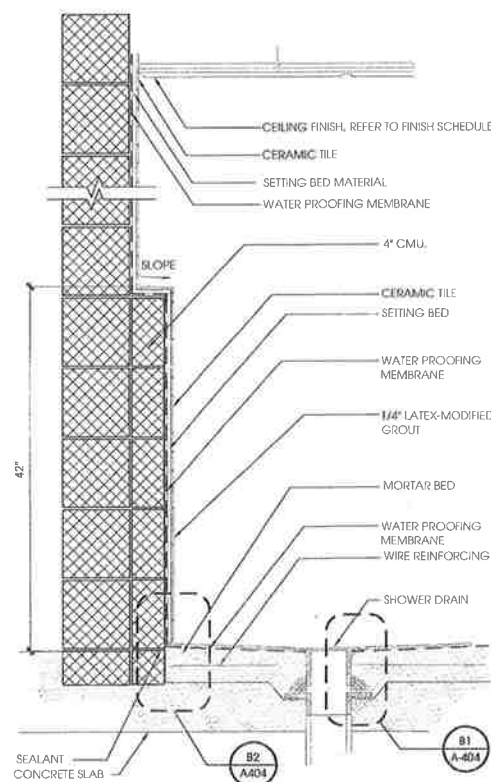

A3 TYPICAL SHOWER SECTION
SCALE: 1 1/2" = 1'-0"

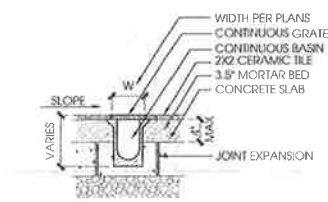

A2 TYPICAL TRENCH DRAIN
SCALE: 1" = 1'-0"

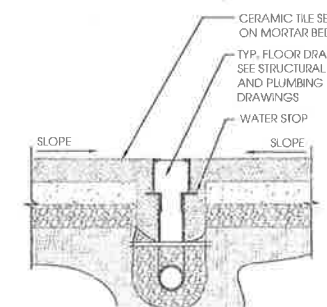

A1 TYPICAL FLOOR DRAIN
SCALE: 1" = 1'-0"

Exhibit B

Wilson Aquatic Center Map

Google Maps

Wilson Aquatic Center

